4637155030

IREDELL COUNTY HEALTH DEPARTMENT

STATESVILLE 704-878-5305 MOORESVILLE 704-664-5281

IMPROVEMENT PERMIT / CERTIFICATE OF COMPLETION / OPERATION PERMIT / EXISTING SYSTEM INSPECTION

PROPERTY DESCRIPTION NO. 21391 DATE 6/21/95 TAX MAP NO. 2P-3-A-64 Watershed: ☒ Yes ☐ No

OWNER OR CONTRACTOR Neville Hailey PHONE: Business 910-377-2668 Home

ADDRESS 5771 Stanleyville Dr. Winston-Salem, NC. 27105

LOCATION 150W Tom McCreary TR on Rivenwood Dr. to # 215 on L

SUBDIVISION C.L.T. BLOCK / SECTION 10 LOT 64 LOT AREA 2/HC SITE CLASS. P DESIGN FLOW 360 L.T.A.R.

Septic Tank: Existing System ~~Gallons; STD~~ Date

Pump Tank: ~~Gallons;~~ PT Date

Pump Make: Model Serial No.

Nitrification Field: No Fields Existing System ~~Square Feet~~ Linear Feet

No Lines Trench Width 0 Max Trench Bottom Depth Gravel Depth

☐ New System ☐ Repair System Type: I, II, III, IV, V, VI

System Description: Existing System

Repair System Description:

Maintenance Agreement Required: ☐ Yes ☐ No

☐ House/Mod. Home No. Bedrooms 3

☒ Mobile Home No. Bathrooms 2

☐ Business No. Employees

☐ Other


☐ Slab ☐ Crawl Space ☐ Basement w/plumbing ☐ Basement wo/plumbing

Water Supply: ☒ Individual ☐ Community ☐ Public


Comments:

Comments:

INITIAL SITE SKETCH

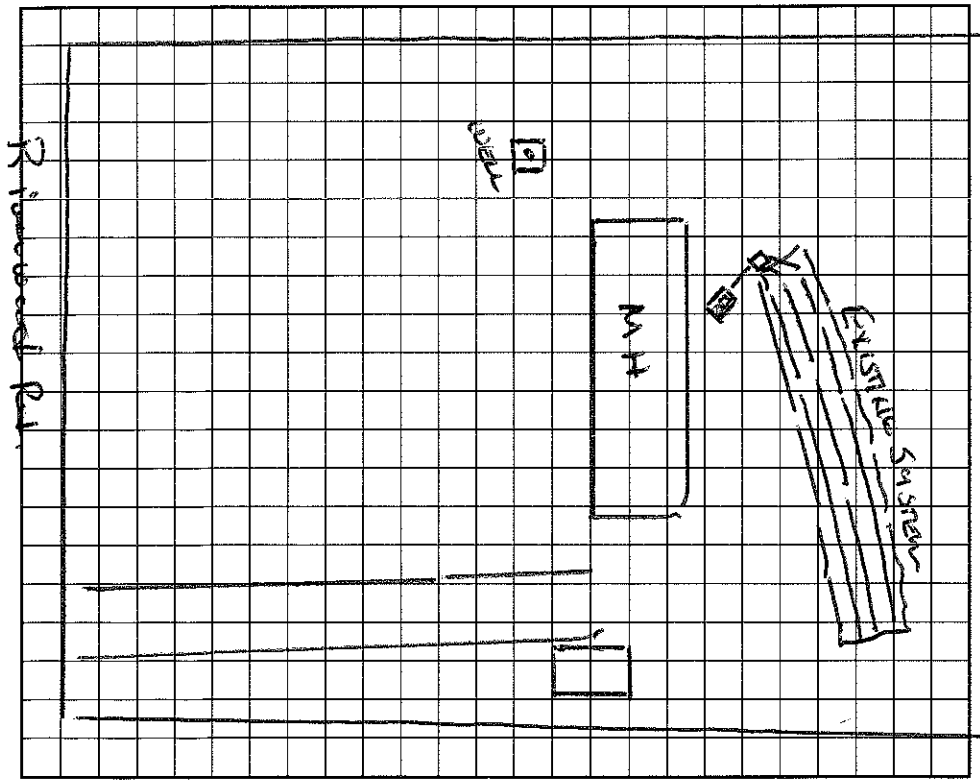

AS BUILT SKETCH

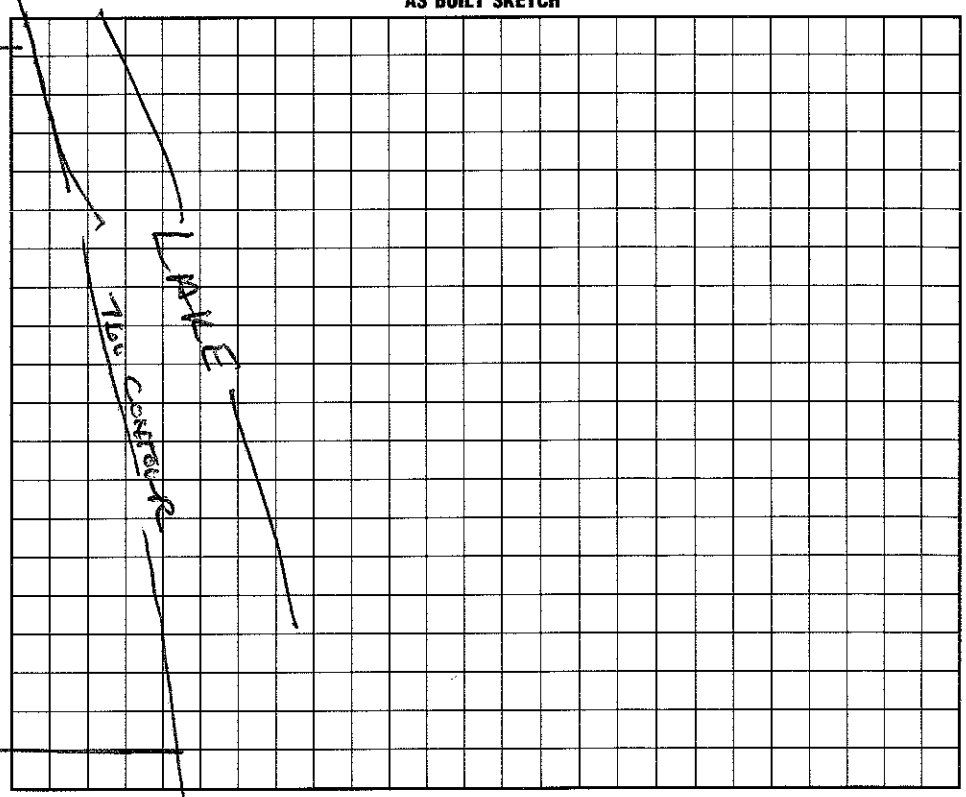

I understand that this permit can be suspended or revoked if any false information is supplied toward securing the permit/any unauthorized changes are made to the site/any unauthorized changes are made in the installation of the system. Improvement Permit is valid for 60 months from date of issuance.

Signed: Installed by:

Improvement Permit by: date Certificate of Completion by: date

Existing System Inspection by: Wesley Sparks date 6/21/95 Operation Permit by: date

HEALTH DEPT. COPY: WHITE INSPECTION COPY (FINAL): GREEN OWNER COPY (FINAL): YELLOW INSPECTION COPY (INITIAL): PINK OWNER COPY (INITIAL): GOLD