IREDELL COUNTY HEALTH DEPARTMENT

STATESVILLE 704-878-5305 MOORESVILLE 704-664-5281

IMPROVEMENT PERMIT / AUTHORIZATION TO CONSTRUCT / OPERATION PERMIT / EXISTING SYSTEM INSPECTION

PERMIT# 119579 PIN# ~~4637166015.000~~ 4637-15-6822 DATE 7/31/04

OWNER OR CONTRACTOR McCRARY PARTNERS PHONE: Business 799-9770 Home

ADDRESS PO Box 3608 MOORESVILLE NC 28117

LOCATION 150 West - TL McCRARY - OWNS

SUBDIVISION McCRARY WOODS BLOCK / SECTION 1 LOT 25 LOT AREA 1.06AC SITE CLASS. PS DESIGN FLOW 480GPD L.T.A.R. .36-80/KF2

Septic Tank: 1000 Gallons; STB 794 Date 12-17-06

Pump Tank: ____ Gallons; PT ____ Date ____

Pump Make: ____ Model ____ Serial No. ____

Nitrification Field: No Fields 1 Square Feet 1200 Linear Feet 400

No Lines 4@100' Trench Width 36" Max Trench Bottom Depth 36" Gravel Depth N/A

☑ New System ☐ Repair System Type: I II III IV V VI

System Description: GRAVITY 25% REDUCTION

Repair System Description: SAME

Maintenance Agreement Required: ☐ Yes ☑ No

☑ House/Mod. Home No. Bedrooms 4

☐ Mobile Home No. Bathrooms 4

☐ Business No. Employees ____

☐ Other ____


☐ Slab ☑ Crawl Space ☐ Basement w/plumbing ☐ Basement wo/plumbing

Water Supply: ☑ Individual ☐ Public ☐ Community


Comments:/Conditions:

Comments:/Conditions:

INITIAL SITE SKETCH 1"=50'

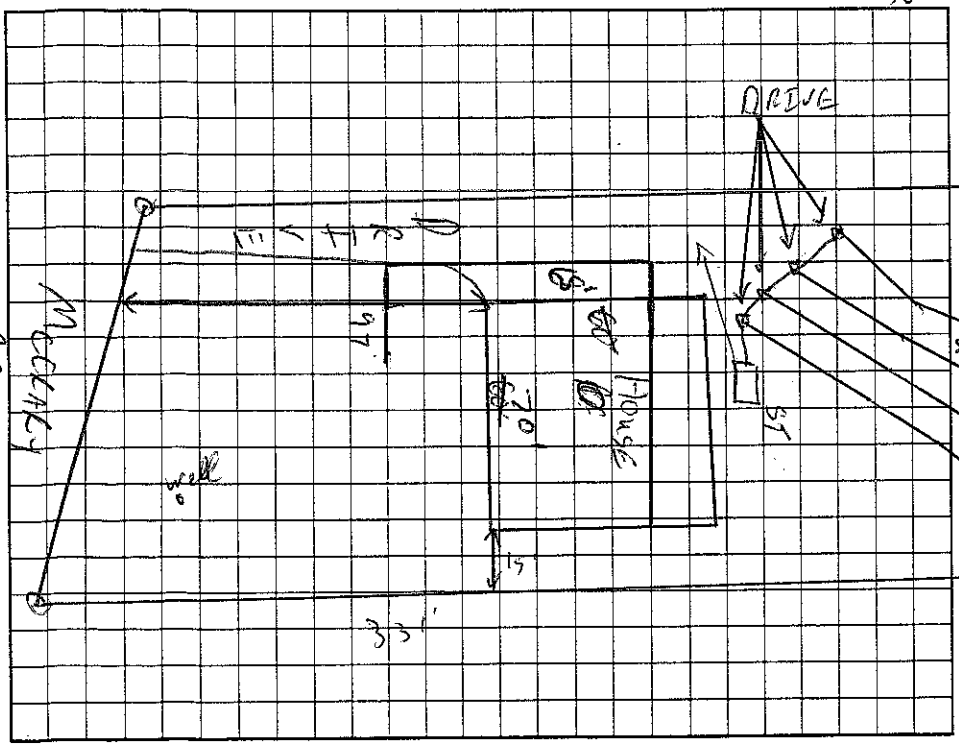

AS BUILT SKETCH

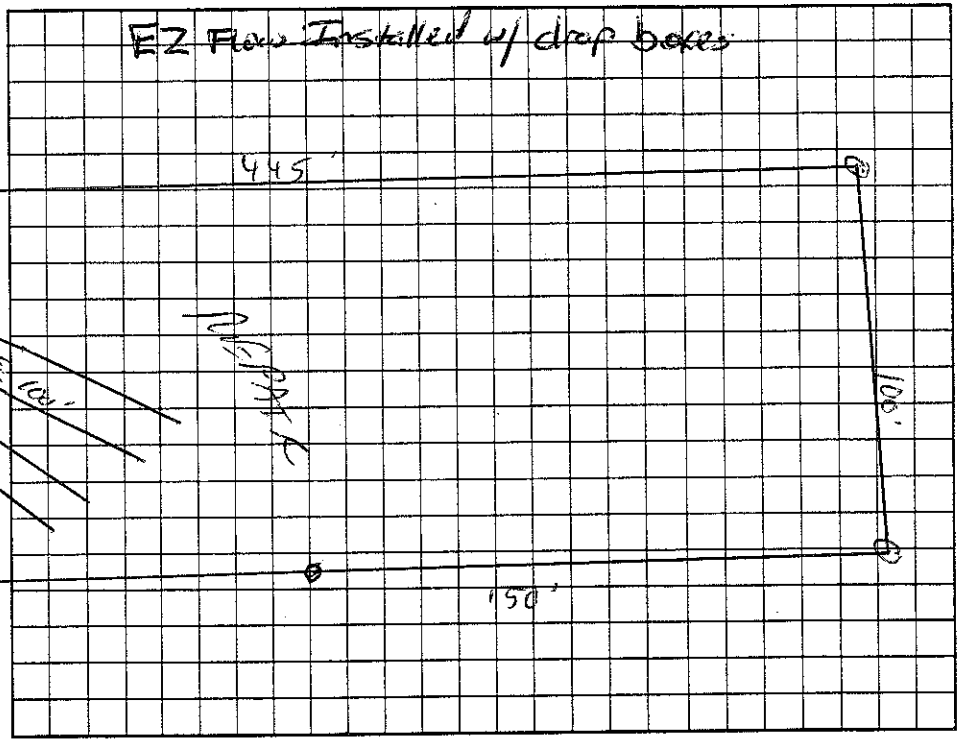

Permit can be suspended or revoked if any false information is supplied toward securing the permit/any unauthorized changes are made to the site/any unauthorized changes are made in the installation of the system. Improvement Permit with plat valid without expiration. Improvement Permit with site plan valid for sixty months. Authorization to Construct is valid for a period equal to that of Improvement Permit – not to exceed sixty months.

Signed: ____ date 8-3-04 Installed by: R+H

Improvement Permit by: ____ date 7/31/04 Operation Permit by: John E Aldt date 3/7/07

Authorization to Construct by: Judy McNeill date 7-17-06 Existing System Inspection by: ____ date ____

HEALTH DEPT. COPY: WHITE OWNER COPY (FINAL): YELLOW OWNER COPY (INITIAL): PINK