130

IREDELL COUNTY HEALTH DEPARTMENT

STATESVILLE 704-878-5305 MOORESVILLE 704-664-5281

IMPROVEMENT PERMIT / AUTHORIZATION TO CONSTRUCT / OPERATION PERMIT / EXISTING SYSTEM INSPECTION

PERMIT# 119580 PIN# ~~4637-16-6015.000~~ 4637-15-6983 DATE 7/31/04

OWNER OR CONTRACTOR McCRARY PARTNERS LLC / EAGLE WING HOMES PHONE: Business 794-9770 Home

ADDRESS PO BOX 3608 MOORESVILLE NC 28117

LOCATION 150 WEST - TL McCRARY - DN RT

SUBDIVISION McCRARY WOODS BLOCK / SECTION 1 LOT 26 LOT AREA .81 AC SITE CLASS PS DESIGN FLOW 480GPD L.T.A.R. 1.30 AC/LOT

Septic Tank: 1000 Gallons; STB 794 Date 8/7/05
Pump Tank: Gallons; PT Date
Pump Make: Model Serial No.
Nitrification Field: No Fields 1 Square Feet 1200 Linear Feet 400
No Lines 4@100' Trench Width 36" Max Trench Bottom Depth 36" Gravel Depth N/A

☑ New System ☐ Repair System Type: I, II, III, IV, V, VI
System Description: GRAVITY 25% REDUCTION
Repair System Description: SAME
Maintenance Agreement Required: ☐ Yes ☑ No

☑ House/Mod. Home No. Bedrooms 4
☐ Mobile Home No. Bathrooms 4
☐ Business No. Employees
☐ Other


☐ Slab ☑ Crawl Space ☐ Basement w/plumbing ☐ Basement wo/plumbing

Water Supply: ☑ Individual ☐ Public ☐ Community


Comments:/Conditions:

Comments:/Conditions:

INITIAL SITE SKETCH 1"=50'

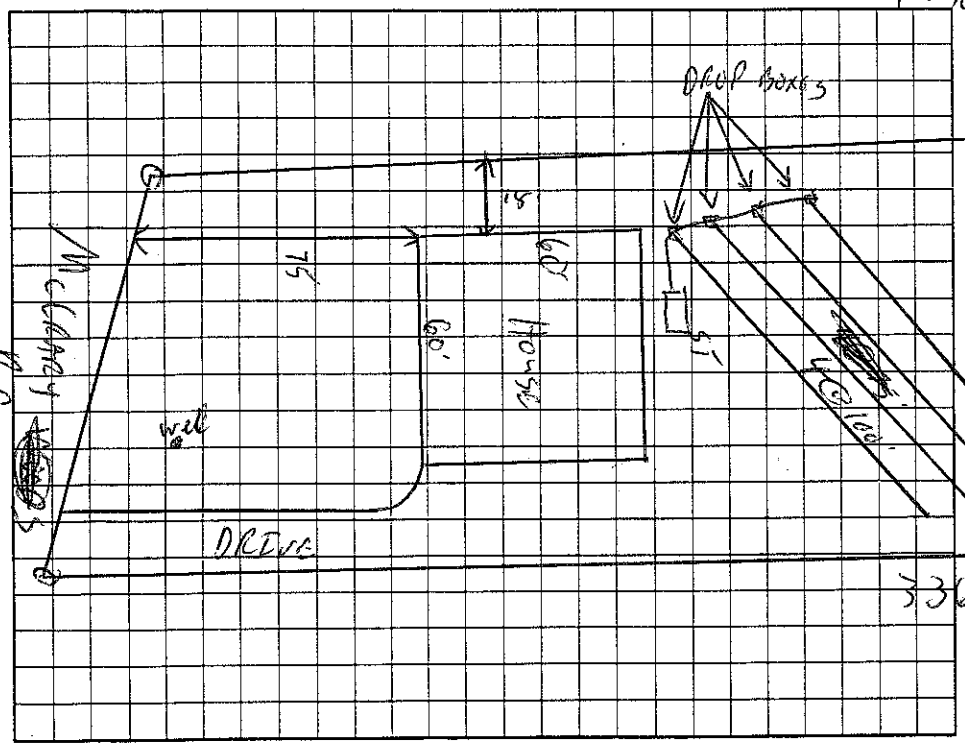

AS BUILT SKETCH

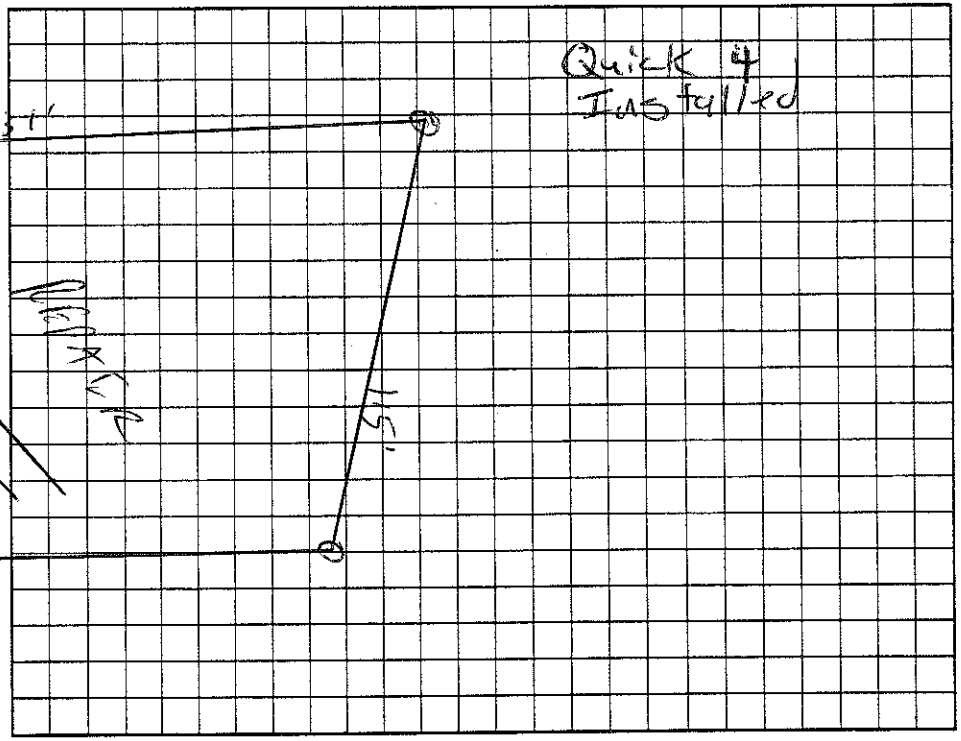

Permit can be suspended or revoked if any false information is supplied toward securing the permit/any unauthorized changes are made to the site/any unauthorized changes are made in the installation of the system. Improvement Permit with plat valid without expiration. Improvement Permit with site plan valid for sixty months. Authorization to Construct is valid for a period equal to that of Improvement Permit – not to exceed sixty months.

Signed: date 8-30-04 Installed by: Abernathy

Improvement Permit by: C. [illegible] RS date 7/31/04 Operation Permit by: [illegible] RS date 9/15/05

Authorization to Construct by: Wesley Sparks RS. date 2/25/05 Existing System Inspection by: date

HEALTH DEPT. COPY: WHITE OWNER COPY (FINAL): YELLOW OWNER COPY (INITIAL): PINK