IREDELL COUNTY HEALTH DEPARTMENT

STATESVILLE 704-878-5305 MOORESVILLE 704-664-5281

IMPROVEMENT PERMIT / AUTHORIZATION TO CONSTRUCT / OPERATION PERMIT / EXISTING SYSTEM INSPECTION

PERMIT# 14629T202464 PIN# 4637251453.016 4637-15-9180 DATE 11-27-07

OWNER OR APPLICANT Lakeland Luxury/True Homes PHONE: Business 704-892-1878 Home

ADDRESS 16405-D Northcross Dr Huntersville NC 28078

LOCATION Hwy 150 W, TL McCrary on left

SUBDIVISION Riverwood Bend BLOCK / SECTION LOT 16 LOT AREA .598 Ac SITE CLASS. PS DESIGN FLOW 480gpd L.T.A.R. .3gpd/ft²

Septic Tank: 1000 Gallons; STB 799 Date 5-17-14
Pump Tank: Gallons; PT Date
Pump Make: Model Serial No.
Nitrification Field: No Fields 1 Square Feet 1200 Linear Feet 400
No Lines 4@100' Trench Width 36" Max Trench Bottom Depth 36"

☒ New System ☐ Repair ☐ Expansion System Type: I II III IV V VI
System Description: 25% reduction gravity
Repair System Description: LP PPBPS
Maintenance Agreement Required: ☐ Yes ☒ No
Gravel Depth NA ☒ Gravity ☐ Pressure ☐ Slab ☒ Crawl Space ☐ Basement w/plumbing ☐ Basement wo/plumbing

☒ House/Mod. Home No. Bedrooms 4
☐ Mobile Home No. Persons 8
☐ Business No. Employees
☐ Other

Water Supply: ☒ Individual ☐ Public ☐ Community

Comments:/Conditions:
System 100'+ from well

Comments:/Conditions: 4/1/14 Reviewed Floor plans & Site plan; in Compliance with original plan

INITIAL SITE SKETCH

See plan from SAME

AS BUILT SKETCH

Permit can be suspended or revoked if any false information is supplied toward securing the permit/any unauthorized changes are made to the site/any unauthorized changes are made in the installation of the system. Improvement Permit with plat valid without expiration ☐ Improvement Permit with site plan valid for sixty months ☒ Authorization to Construct is valid for a period equal to that of Improvement Permit – not to exceed sixty months.

Signed: date 12/6/07

Improvement Permit by: date 11-27-07


Authorization to Construct by: RS date 4/1/14

Installed by: OWNER

Operation Permit by: date 7-1-14

Existing System Inspection by: date

HEALTH DEPT. COPY: WHITE OWNER COPY (FINAL): YELLOW OWNER COPY (INITIAL): PINK

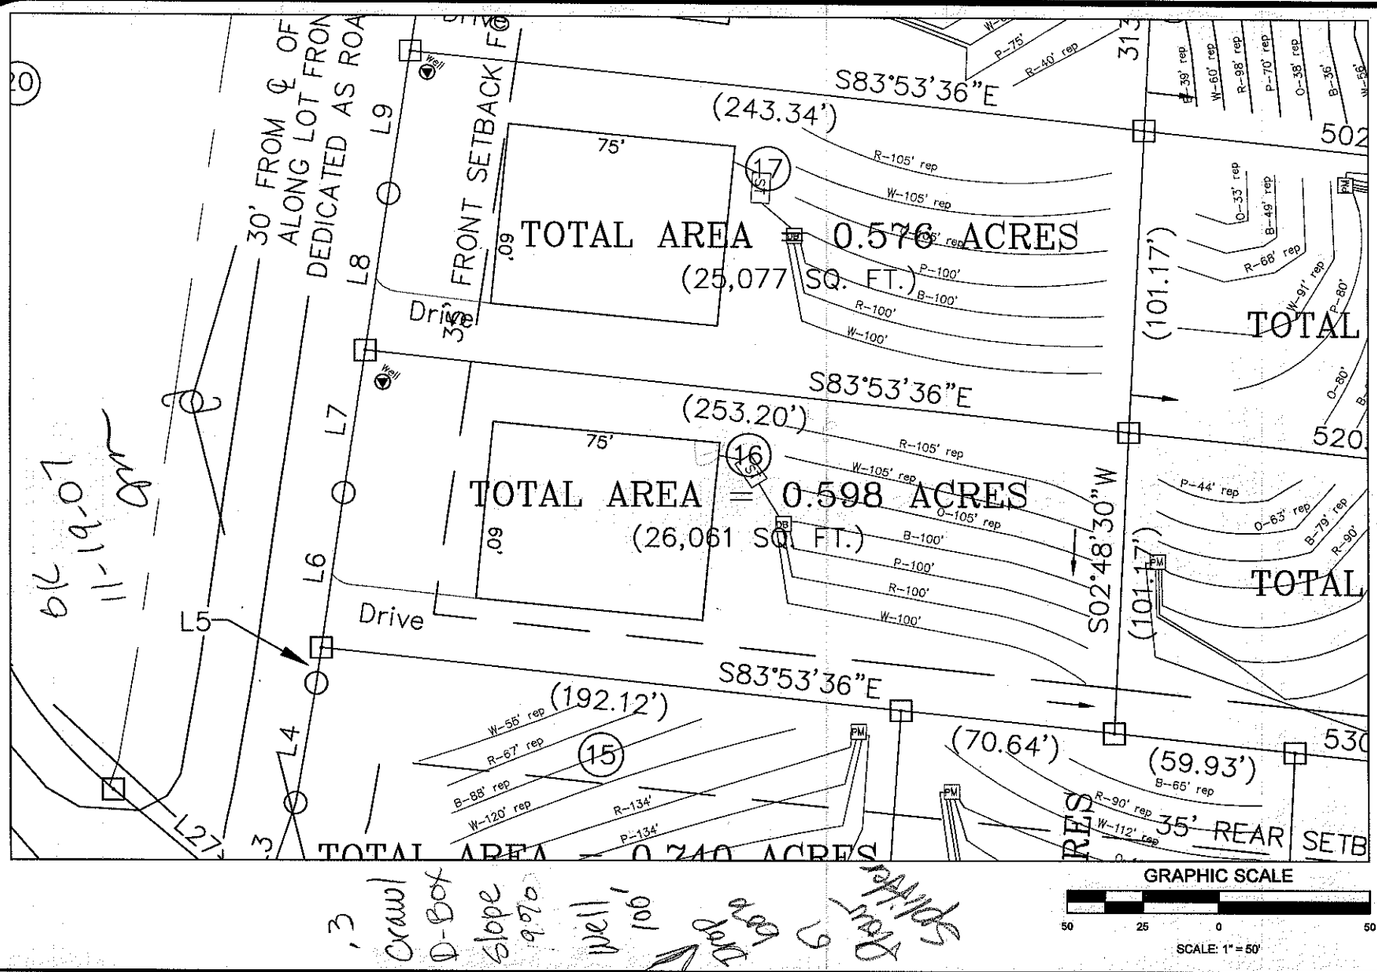

SCALE: 1" = 50'	DATE: 11-14-07	S&ME 3718 OLD BATTLEGROUND ROAD GREENSBORO, NC 27410 PH. 336-288-7180 FAX. 336-288-8980 WWW.SMEINC.COM	Lot 16 Riverwood Bend Subdivision – McCrary Rd. Iredell County, NC	FIGURE NO. 1
PROJECT NO. 1588-07-051	DRAWN BY: JBP			
	CHECKED BY: PLM			