IREDELL COUNTY HEALTH DEPARTMENT

STATESVILLE 704-878-5305 MOORESVILLE 704-664-5281

IMPROVEMENT PERMIT / AUTHORIZATION TO CONSTRUCT / OPERATION PERMIT / EXISTING SYSTEM INSPECTION

DATE 11-27-07

PERMIT# 446300 20276 PIN# 4637254534.018 4637-15-9340 PHONE: Business 704-892-1828 Home

OWNER OR APPLICANT Lakeland Luxury/True Homes

ADDRESS 16405-D Northcross Dr Huntersville NC 28078 / 2649 Breckenridge Ctr Dr Monroe NC 28110

LOCATION Hwy 150 W TL McCrary on left, 329 McCrary Rd

SUBDIVISION Riverwood Bend BLOCK / SECTION LOT 18 LOT AREA .61 Ac SITE CLASS PS DESIGN FLOW 480gpd L.T.A.R. .3gpd/ft2

Septic Tank: 1000 Gallons: STB Date

Pump Tank: Gallons: PT Date

Pump Make: Model Serial No.

Nitrification Field: No Fields 1 Square Feet 1200 Linear Feet 400

No Lines 5 Trench Width 36" Max Trench Bottom Depth 36"

☒ New System ☐ Repair ☐ Expansion System Type: I II III IV V VI

System Description: 25% reduction gravity

Repair System Description: 2PPPBPS

Maintenance Agreement Required: ☐ Yes ☒ No

Gravel Depth NA ☒ Gravity ☐ Pressure ☐ Slab ☒ Crawl Space ☐ Basement w/plumbing ☐ Basement wo/plumbing

☒ House/Mod. Home ☐ Mobile Home ☐ Business ☐ Other

No. Bedrooms 4 No. Persons 8 No. Employees

Water Supply: ☐ Individual ☐ Public ☐ Community

Comments:/Conditions:

Install at 36" trench depth

Comments:/Conditions:

INITIAL SITE SKETCH

See plan from SAME

AS BUILT SKETCH

Permit can be suspended or revoked if any false information is supplied toward securing the permit/any unauthorized changes are made to the site/any unauthorized changes are made in the installation of the system. Improvement Permit with plat valid ~~without~~ expiration ☐ Improvement Permit with site plan valid for sixty months ☒ Authorization to Construct is valid for a period equal to that of Improvement Permit – not to exceed sixty months.

Signed: date 12/6/07

Improvement Permit by: date 11-27-07


Authorization to Construct by: date 4-15-14

Installed by: date

Operation Permit by: HOWARD date 7-2-14

Existing System Inspection by: date

HEALTH DEPT. COPY: WHITE OWNER COPY (FINAL): YELLOW OWNER COPY (INITIAL): PINK

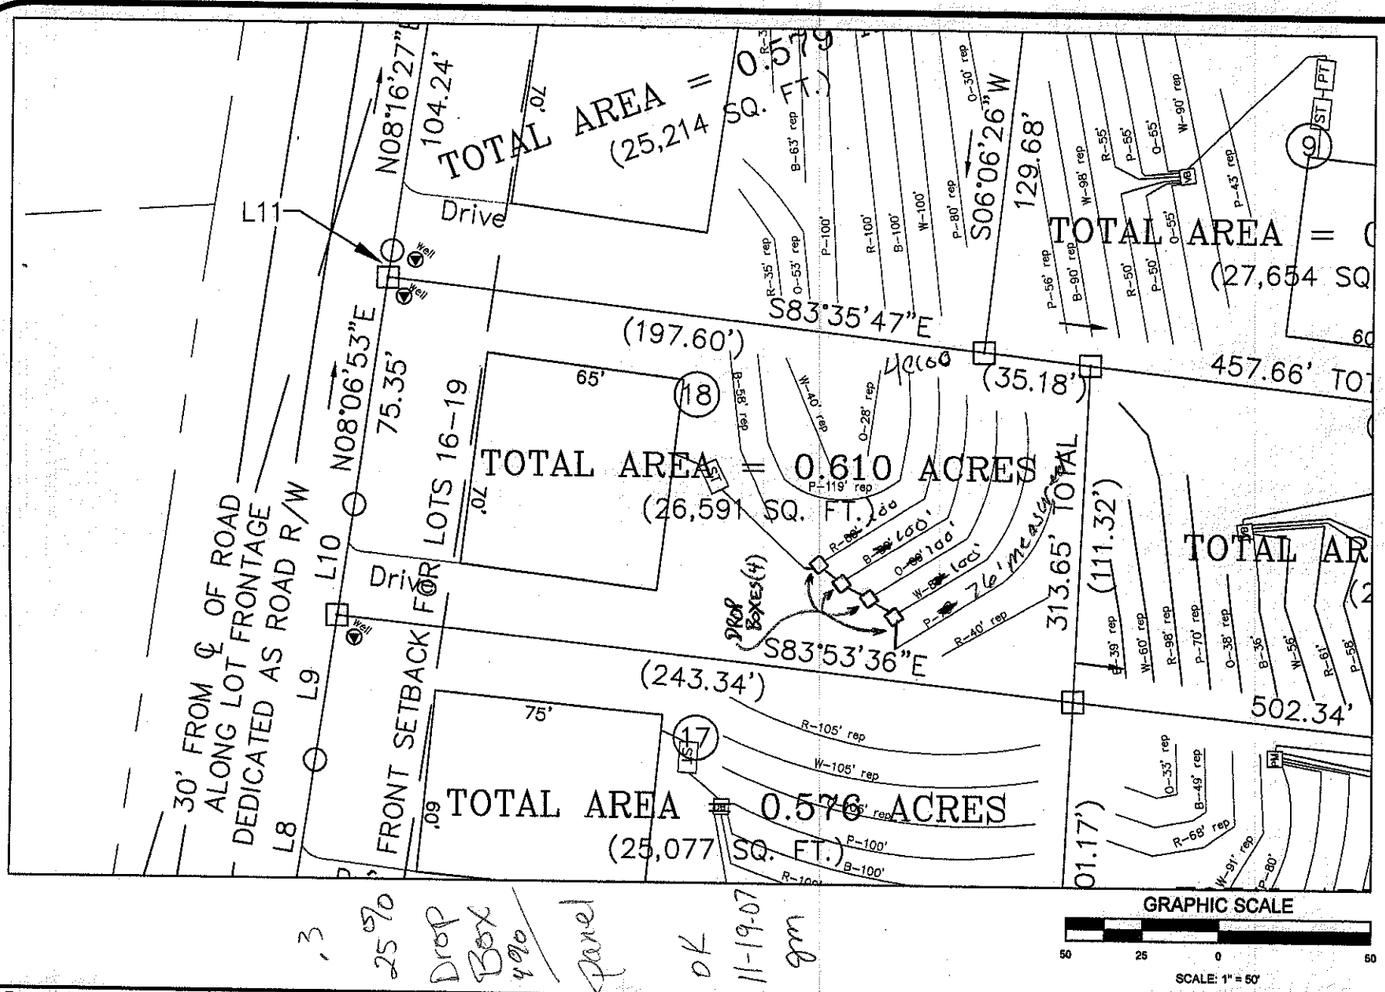

3 2570 Drop Box 490 Panel OK 11-19-07 gm

SCALE: 1" = 50'	DATE: 11-14-07	S&ME 3718 OLD BATTLEGROUND ROAD GREENSBORO, NC 27410 PH. 336-288-7180 FAX. 336-288-8980 WWW.SMEINC.COM	Lot 18 Riverwood Bend Subdivision – McCrary Rd. Iredell County, NC	FIGURE NO. 1
PROJECT NO. 1588-07-051	DRAWN BY: JBP			
	CHECKED BY: PLM			