IREDELL COUNTY HEALTH DEPARTMENT

STATESVILLE 704-878-5305 MOORESVILLE 704-664-5281

IMPROVEMENT PERMIT / AUTHORIZATION TO CONSTRUCT / OPERATION PERMIT / EXISTING SYSTEM INSPECTION

PERMIT# 146301 20169G PIN# 4637254532.019 4637159481 DATE 11-27-07

OWNER OR APPLICANT Lakeland Luxury / True Homes PHONE: Business 704-892-1828 Home

ADDRESS 16405-D Northcross Dr / Huntersville NC 28078

LOCATION Hwy 150 W to McCrary on left

SUBDIVISION Riverwood Bend BLOCK / SECTION 1 LOT 19 LOT AREA .579 Ac SITE CLASS. PS DESIGN FLOW 480 gpd L.T.A.R. .3 gpd/ft2

Septic Tank: 1000 Gallons; STB 794 Date 5-12

Pump Tank: Gallons; PT Date

Pump Make: Model Serial No.

Nitrification Field: No Fields 1 Square Feet 1200 Linear Feet 400

No Lines 4 @ 100' Trench Width 36" Max Trench Bottom Depth 36"

☒ New System ☐ Repair ☐ Expansion System Type: I II III IV V VI

System Description: 25% reduction gravity

Repair System Description: LPPBPS

Maintenance Agreement Required: ☐ Yes ☒ No

☒ House/Mod. Home No. Bedrooms 4

☐ Mobile Home No. Persons 8

☐ Business No. Employees

☐ Other

Water Supply: ☒ Individual ☐ Public ☐ Community

Gravel Depth N/A ☒ Gravity ☐ Pressure ☐ Slab ☒ Crawl Space ☐ Basement w/plumbing ☐ Basement wo/plumbing

Comments:/Conditions: Install at 36" trench bottom

System 100' + from well

Comments:/Conditions: 4/1/14 Reviewed Floor plans, in Compliance with original permit.

INITIAL SITE SKETCH

See plan from SAME

AS BUILT SKETCH

INSTALLED AS SHOWN ON PLAN


Permit can be suspended or revoked if any false information is supplied toward securing the permit/any unauthorized changes are made to the site/any unauthorized changes are made in the installation of the system. Improvement Permit with plat valid without expiration ☐ Improvement Permit with site plan valid for sixty months ☒ Authorization to Construct is valid for a period equal to that of Improvement Permit – not to exceed sixty months.

Signed: date 12/6/07 Installed by: Howard

Improvement Permit by: date 11-27-07 Operation Permit by: date 7-2-14

Authorization to Construct by: RS date 4/1/14 Existing System Inspection by: date

HEALTH DEPT. COPY: WHITE OWNER COPY (FINAL): YELLOW OWNER COPY (INITIAL): PINK

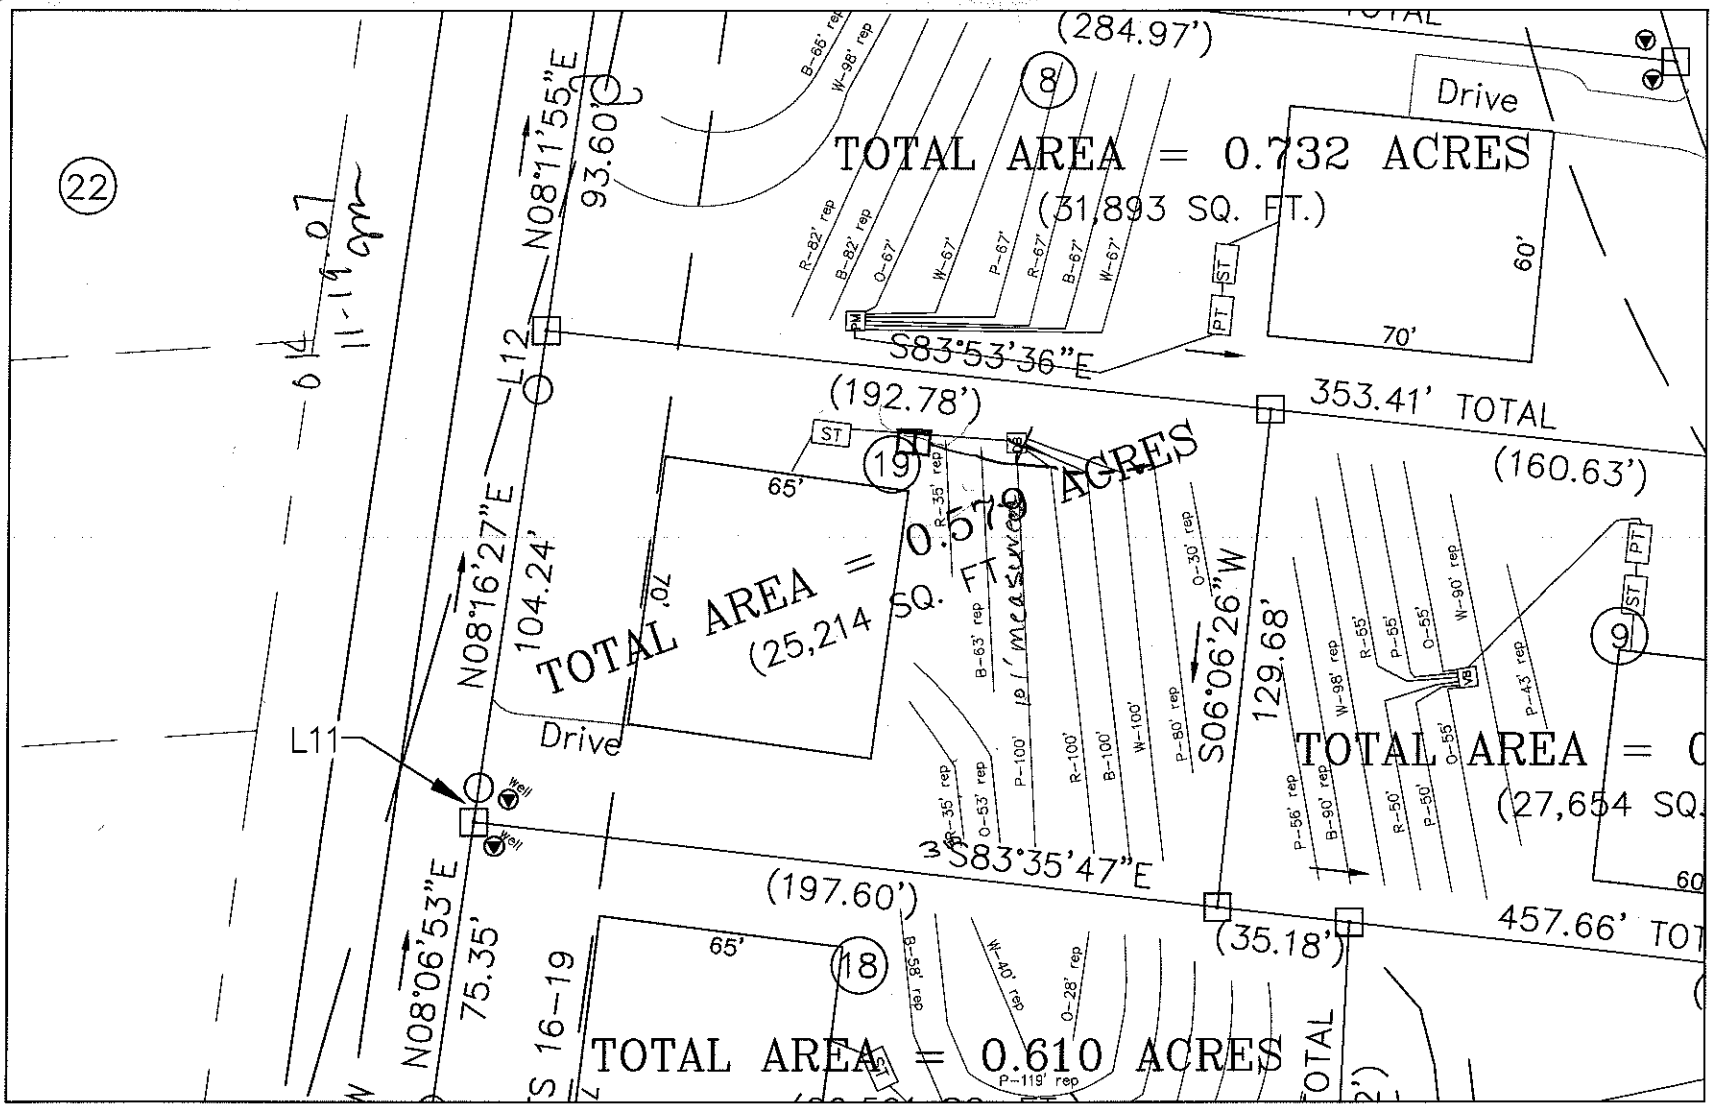

SCALE: 1" = 50'	DATE: 11-14-07	S&ME 3718 OLD BATTLEGROUND ROAD GREENSBORO, NC 27410 PH. 336-288-7180 FAX. 336-288-8980 WWW.SMEINC.COM	Lot 19 Riverwood Bend Subdivision – McCrary Rd. Iredell County, NC	FIGURE NO. 1
PROJECT NO. 1588-07-051	DRAWN BY: JBP			
	CHECKED BY: PLM			