IREDELL COUNTY HEALTH DEPARTMENT

↗ AUTHORIZATION TO CONSTRUCT

(200)4637161529

STATESVILLE 704-878-5305

MOORESVILLE 704-664-5281

IMPROVEMENT PERMIT / ~~CERTIFICATE OF COMPLETION~~ / OPERATION PERMIT / EXISTING SYSTEM INSPECTION

PROPERTY DESCRIPTION NO. 26190 DATE 2/19/97

OWNER OR CONTRACTOR ANDREW & ANGIE HOLT TAX MAP NO. 4637155995

ADDRESS 143 JAMESTOWNE DR. MOCKSVILLE NC 27028 PHONE: Business _____ Home 910-998-4541 Watershed: ☐ Yes ☐ No

LOCATION 150 YD TL MCCLARY DR - ON RT ≈ 700' OFF RD - RT PAST LITTLE CHAPMAN LN

SUBDIVISION _____ BLOCK / SECTION _____ LOT _____ LOT AREA _____ SITE CLASS. _____ DESIGN FLOW _____ L.T.A.R. _____

Septic Tank: 1000 Gallons; STB 794 Date 2/30/98

Pump Tank: _____ Gallons; PT _____ Date _____

Pump Make: _____ Model _____ Serial No. _____

Nitrification Field: No Fields 1 Square Feet 900 Linear Feet 300

No Lines 4@75' Trench Width 36" Max Trench Bottom Depth 36" ~~Gravel Depth~~ SAND

☑ New System ☐ Repair System Type: I, II, III, IV, V, VI

System Description: GRAVITY CHAMBERED - SEPTAR

Repair System Description: PUMP PANEL

Maintenance Agreement Required: ☐ Yes ☐ No

☑ House/Mod. Home ☐ Mobile Home ☐ Business ☐ Other

No. Bedrooms 3 No. Bathrooms 3 No. Employees ____

☐ Slab ☐ Crawl Space ☑ Basement w/plumbing ☐ Basement wo/plumbing


Water Supply: ☑ Individual ☐ Community ☐ Public

Comments:

Comments:

INITIAL SITE SKETCH 1"=60'

AS BUILT SKETCH

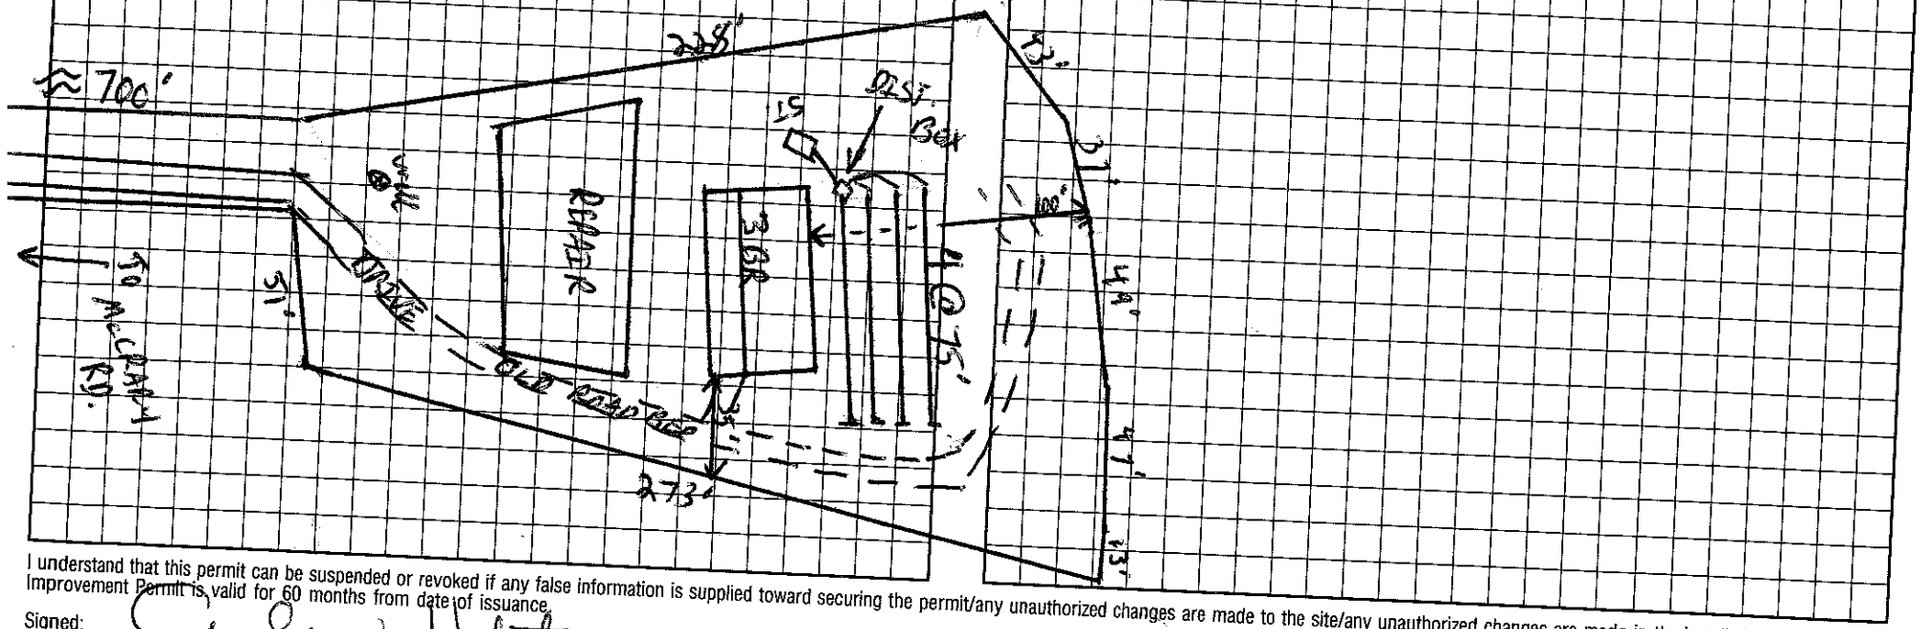

I understand that this permit can be suspended or revoked if any false information is supplied toward securing the permit/any unauthorized changes are made to the site/any unauthorized changes are made in the installation of the system. Improvement Permit is valid for 60 months from date of issuance.

Signed: Andrew Holt

Improvement Permit by: EHS date 2/19/97

~~Existing System Inspection by:~~ AUTHORIZATION TO CONSTRUCT EHS date 2/19/97

Installed by: W. CHRISTENBERRY

Certificate of Completion by: _____ date _____

Operation Permit by: _____ date 6/25/98

HEALTH DEPT. COPY: WHITE INSPECTION COPY (FINAL): GREEN OWNER COPY (FINAL): YELLOW INSPECTION COPY (INITIAL): PINK OWNER COPY (INITIAL): GOLD