STATESVILLE [illegible]-5305 MOORESVILLE 704-664-5281

IREDELL COUNTY HEALTH DEPARTMENT

IMPROVEMENT PERMIT / AUTHORIZATION TO CONSTRUCT / OPERATION PERMIT / EXISTING SYSTEM INSPECTION

DATE 6/25/09

PERMIT # 131253 PIN # 4637 16 2723 PHONE: Business Home:

OWNER or APPLICANT WAYNE PARKER

OWNER or APPLICANT ADDRESS 597 PRESBYTERIAN RD. MOORESVILLE, NC. 28115

LOCATION / DIRECTIONS I-40 W TO McCLAMROCK, TR HOLT LN, ON (R) OFF CUL DE SAC

SUBDIVISION CL+T BLOCK / SECTION 10 LOT # 95A LOT AREA 4.8AC DESIGN FLOW 600 L.T.A.R. .3

Septic Tank 1500 Gallons: STB 528 Date 11-17-08

Pump Tank 1500 Gallons: PT 485 Date 3-9-09

Pump Make GOULDS Model WE6I2H Serial # 1 H/P

Nitrification Field No Fields 1 No Lines 6 Linear Feet 353

Trench Width 2-3' Max. Trench Bottom Depth 3' Gravel Depth No

☒ New System ☐ Repair ☐ Expansion System Type I II III (IV) V VI

System Description: LP - 16" PPBPS

Repair System Description: SAME

Maintenance Agreement Required ☐ YES ☐ NO

☐ GRAVITY ☒ PRESSURE

☒ Residence No. Bedrooms 5

☐ Business No. Persons

☐ Other No. Employees

☐ Slab ☐ Crawl Space

☒ Basement w/plumbing ☐ Basement w/o plumbing

Water Supply: ☒ Private ☐ Public ☐ Community

Comments / Conditions: Tanks/lines Checked by BA. 6/14/2010 Attempted pressure test - 1st not wired right, then not enough water. Tried to set 2 PT of pressure on 6 lines & kept running out of water. (At site 1.5 hrs)

Comments / Conditions: 4/22/10 Checked Drainlines & ~~Pump~~ Valve Box BA 4/20/10 Checked Tanks

INITIAL SITE SKETCH

FAST TRACK REDRAW BY S+ME, MOORESVILLE

NO VARIATION WITHOUT ICHD APPROVAL.

AS BUILT SKETCH

1ST	10 PANELS
2ND	11
3RD	13
4TH	13
5TH	15
6TH	16

TOTAL OF ~353' OF DRAIN LINE

TRENCHES 24" WIDE

The proposed / existing Inground Pool addition does not appear to impact the existing septic system.

**NOTE: Pool cut must be at least 15' from Septic

Maria Folsom R.S.

Date: 3/27/2012

ICHD-Environmental Health Division

Permit can be suspended or revoked if any false information is supplied toward securing the permit / any unauthorized changes are made to the site / any unauthorized changes are made in the installation of the system.

☒ *IMPROVEMENT PERMIT w / plat valid without expiration.* ☐ *IMPROVEMENT PERMIT w / site plan valid for 60 mos.* ☐ *AUTHORIZATION TO CONSTRUCT valid for period equal to IMPROVEMENT PERMIT-not to exceed 60 mo.*

Owner / Applicant Signature: Kathleen Saunders Date 6/29/09

Improvement Permit by: Wesley Sparks R.S. Date 6/25/09

Authorization to Construct by: Wesley Sparks R.S. Date 7/14/09


Installed by: Grandbreakers Grading KELLS Date 6/15/2

Operation Permit by: Maria Folsom Date:

Existing System Inspected by: Date:

YOU SHOULD CONTACT A LOCATOR SERVICE PRIOR TO ANY EXCAVATION.

WHITE COPY Environmental Health YELLOW COPY (Final) Owner / Applicant PINK COPY (Initial) Owner / Applicant

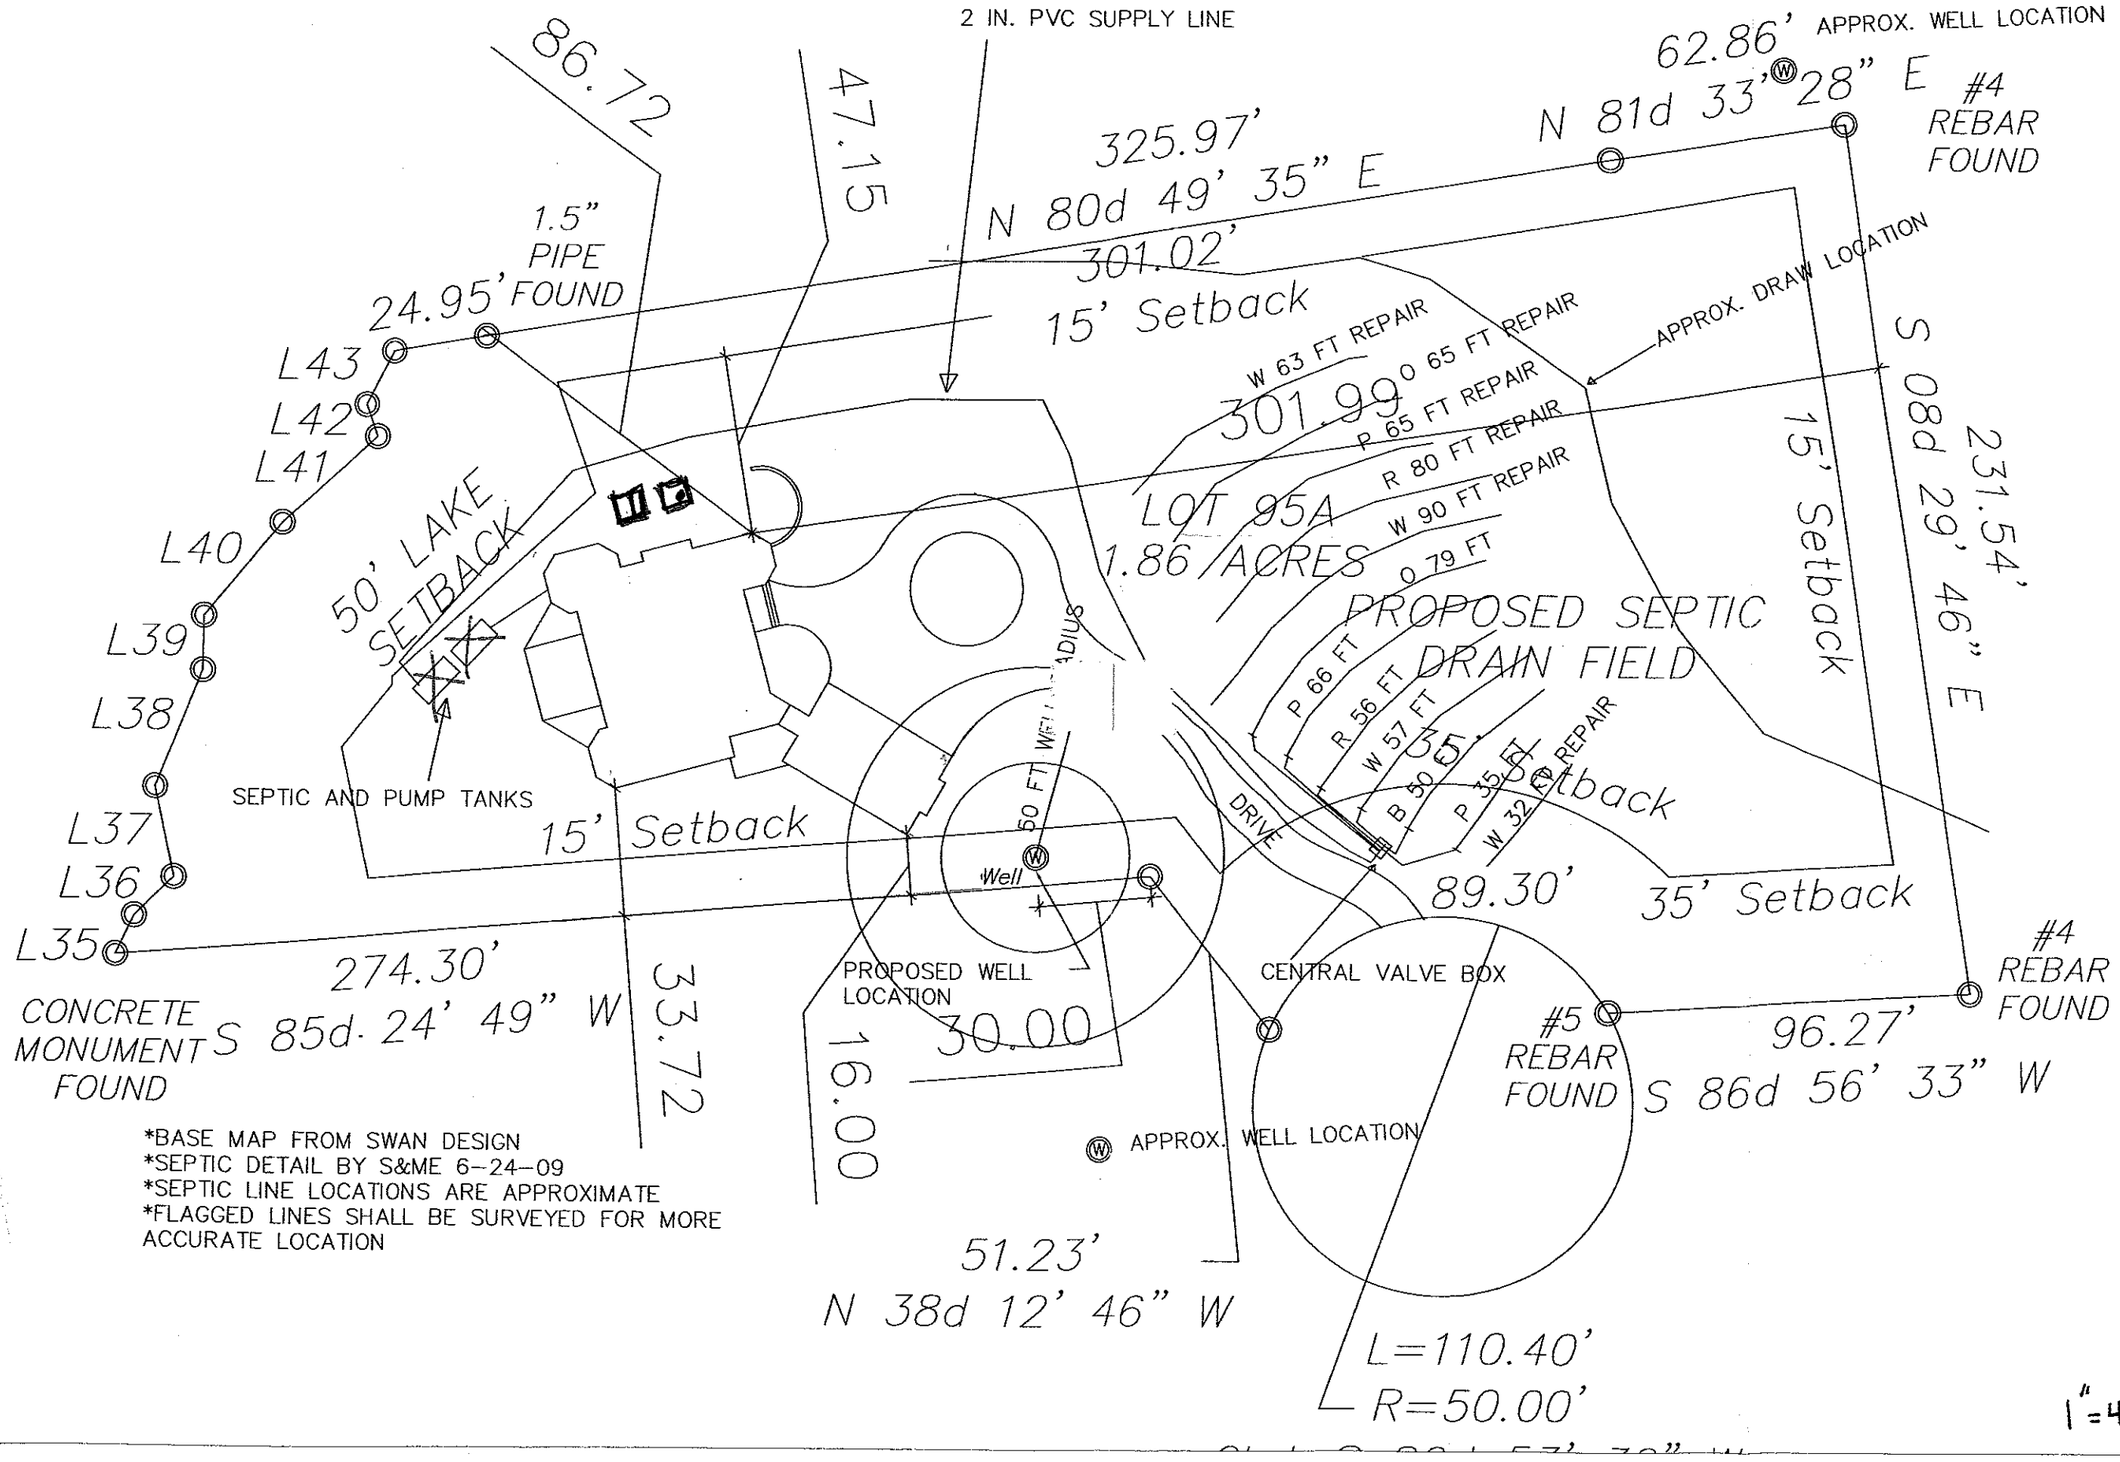

*BASE MAP FROM SWAN DESIGN
*SEPTIC DETAIL BY S&ME 6-24-09
*SEPTIC LINE LOCATIONS ARE APPROXIMATE
*FLAGGED LINES SHALL BE SURVEYED FOR MORE ACCURATE LOCATION