IREDELL COUNTY HEALTH DEPARTMENT

→ Authorization to Construct

STATESVILLE 704-878-5305 MOORESVILLE 704-664-5281

IMPROVEMENT PERMIT / ~~CERTIFICATE OF COMPLETION~~ / OPERATION PERMIT / EXISTING SYSTEM INSPECTION

PROPERTY DESCRIPTION NO. 22697 DATE 4/17/96 TAX MAP NO. 2L-A-48 Watershed: ☑ Yes ☐ No

OWNER OR CONTRACTOR L.S. Reese ~~PHONE: Business~~ 4637-16-2953 Home 535-4030

ADDRESS 1561 Willow Park Dr. Charlotte 28205

LOCATION 150W - TL McCrary Rd - TR Hidden Harbor Rd - lot on Rt.

SUBDIVISION Hidden Harbor BLOCK / SECTION ____ LOT 3A LOT AREA .765ac SITE CLASS. RS DESIGN FLOW 360 gpd T.A.R. .3 gal/sq ft

Septic Tank: 1000 Gallons; STB 794 Date 3/19/96

Pump Tank: ____ Gallons; PT ____ Date ____

Pump Make: ____ Model ____ Serial No. ____

Nitrification Field: No Fields 1 Square Feet 900 Linear Feet 320

No Lines 4 Trench Width 36" Max Trench Bottom Depth 36" Gravel Depth N/A

☑ New System ☐ Repair System Type: I, II, (III), IV, V, VI

System Description: Gravity Chamber

Repair System Description: Pump Panel

Maintenance Agreement Required: ☐ Yes ☑ No

☐ House/Mod. Home No. Bedrooms 3

☑ Mobile Home No. Bathrooms 2

☐ Business No. Employees ____

☐ Other ____

☐ Slab ☑ Crawl Space ☐ Basement w/plumbing ☐ Basement wo/plumbing


Water Supply: ☑ Individual ☐ Community ☐ Public

Comments:


Comments:

14

INITIAL SITE SKETCH

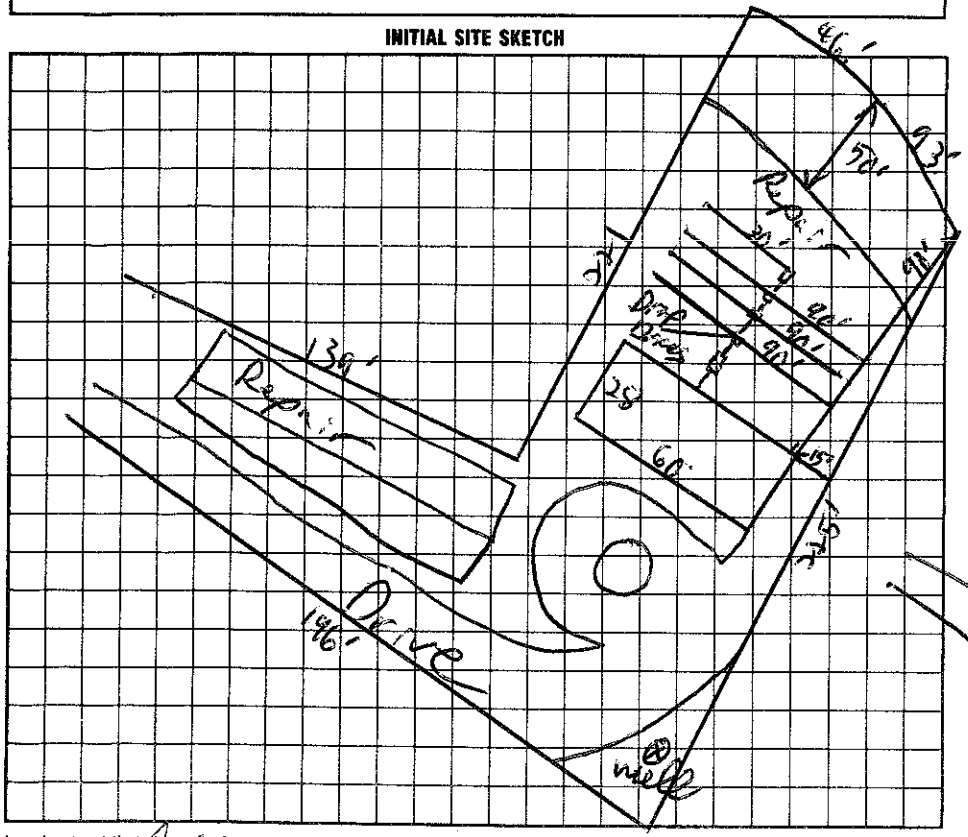

AS BUILT SKETCH

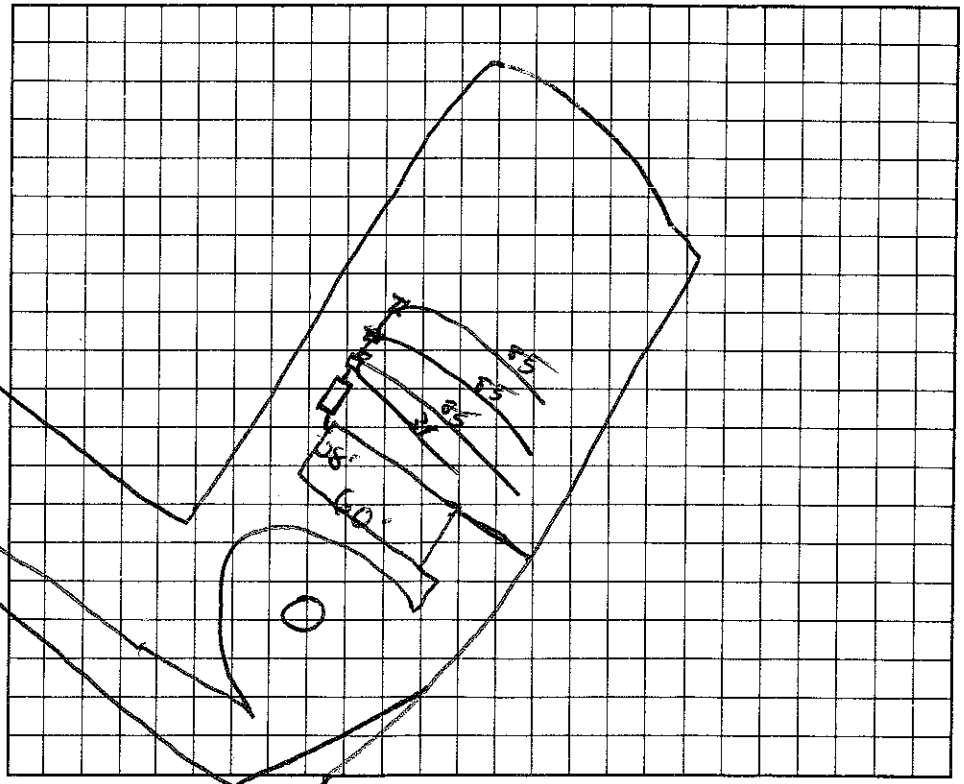

I understand that this permit can be suspended or revoked if any false information is supplied toward securing the permit/any unauthorized changes are made to the site/any unauthorized changes are made in the installation of the system.

Signed: L.S. Reese

Improvement Permit by: C. Rudy Thomas EHSI date 4/17/96

~~Existing System~~ Inspection by: C. Rudy Thomas EHSI date 4/17/96

Authorization to Construct

Installed by: A-1 Backhoe

Certificate of Completion by: ____ date ____

Operation Permit by: C. Rudy Thomas EHSI date 7/1/96

HEALTH DEPT. COPY: WHITE INSPECTION COPY (FINAL): GREEN OWNER COPY (FINAL): YELLOW INSPECTION COPY (INITIAL): PINK OWNER COPY (INITIAL): GOLD

Authorization to Construct is valid for 60 months from issue date.