IREDELL COUNTY HEALTH DEPARTMENT

Statesville Office (704) 878-5305 | Mooresville Office (704) 660-3625 | PERMIT # 208635

IMPROVEMENT PERMIT / AUTHORIZATION TO CONSTRUCT / OPERATION PERMIT / EXISTING SYSTEM

PIN # 4637164027

APPLICANT: Robert Schuberth | APPLICANT ADDRESS: P.O. Box 1768 Salisbury, NC 28145

SITE ADDRESS: 386 Riverwood Mooresville, NC 281 | PHONE: | ALT. PHONE: 704 202-3341

SITE DIRECTIONS: Hwy 150 W TL McCrary TR Riverwood at end

SUBDIVISION: McCrary Woods | SECTION: 1 | LOT # 13 | LOT AREA: 2.62 Acre | DESIGN FLOW: 480gpd | T.A.R.: .3


Septic Tank	1000 (gal)	STB	Date	☒ New System ☐ Repair ☐ Expansion	System Type: I II (III) IV V VI	☒ Residence	No. Bedrooms 4
Pump Tank	(gal)	PT	Date	System Description: Gravity - 25% Reduction		☐ Business	No. Persons 8
Pump Make	Model		Serial #	Repair System Description: Gravity w/ Pump - 25% Reduction		☐ Other	No. Employees
# Nitrification Fields 1	# Lines 4		Linear Ft: 400ft	Maintenance Agreement Required: ☐ YES ☒ NO		☐ Slab	☒ Crawl Space
Trench Width 36"	Max. Trench Bottom Depth 36"		Gravel Depth N/A	☒ GRAVITY ☐ PRESSURE		☐ Basement w/plumbing	☐ Basement w/o plumbing

Water Supply: ☒ Private ☐ Public ☐ Community

Comments / Conditions: Divert stormwater / Surface water Away from Septic System.

Installed Brick for Drainfield ST - 5ft from House.

INITIAL SITE SKETCH

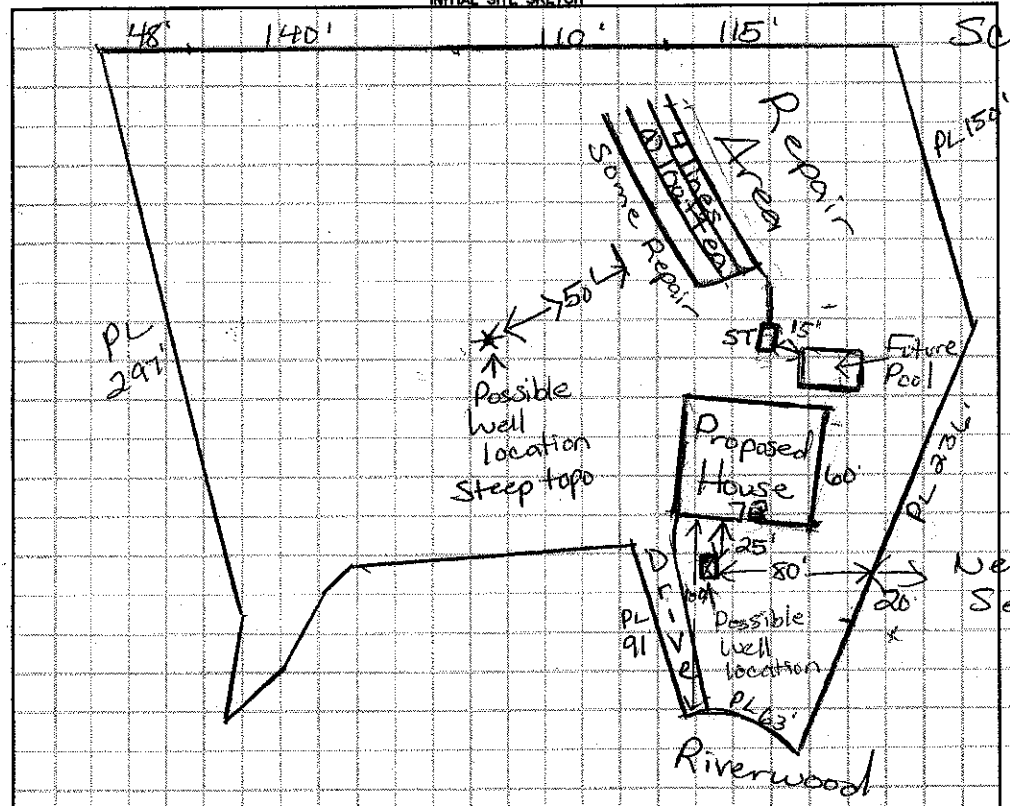

AS BUILT SKETCH

Permit can be suspended or revoked if any false information is supplied toward securing the permit / any unauthorized changes are made to the site / any unauthorized changes are made in the installation of the system. **CONTACT A LOCATOR SERVICE PRIOR TO ANY EXCAVATION**

☐ **IMPROVEMENT PERMIT** *with plat valid without expiration.* ☒ **IMPROVEMENT PERMIT** *with site plan valid for 60 mos.* ☒ **AUTHORIZATION TO CONSTRUCT** *valid for period equal to IMPROVEMENT PERMIT--not to exceed 60 mo.*

Owner / Applicant Signature: Robert Schuberth Date: 4-7-15

IMPROVEMENT PERMIT by: Maria H. Dolan RS Date: 4/6/15

AUTHORIZATION TO CONSTRUCT by: Maria H. Dolan RS Date: 4/6/15

Installed by: Randy Miller RS Date: 9/1/15

OPERATION PERMIT by: Maria H. Dolan RS Date:

Existing System Inspected by: Date:

Health Dept. Copy - WHITE Applicant (Final Approval) - YELLOW Applicant (Conditional Approval) - PINK