4637 16 4889 (2.00)

IREDELL COUNTY HEALTH DEPARTMENT

STATESVILLE 704-878-5305 MOORESVILLE 704-664-5281

IMPROVEMENT PERMIT / CERTIFICATE OF COMPLETION / OPERATION PERMIT / EXISTING SYSTEM INSPECTION

PROPERTY DESCRIPTION NO. 18307 DATE June 9, '95 TAX MAP NO. 2L A19 Watershed: ☐ Yes ☐ No

OWNER OR CONTRACTOR Will Chapman PHONE: Business _____ Home 664-2894 WS4

ADDRESS 260 McCrary Rd, Mooresville

LOCATION 150' W TR McCrary Rd TR Hidden Harbor Rd at end

SUBDIVISION _____ BLOCK / SECTION _____ LOT _____ LOT AREA 1.6ac SITE CLASS. RS DESIGN FLOW 240gpd L.T.A.R. .3

Septic Tank: 1000 Gallons; STB 1012 Date 10/2/99

Pump Tank: _____ Gallons; PT _____ Date _____

Pump Make: _____ Model _____ Serial No. _____

Nitrification Field: No Fields 1 Square Feet 800 Linear Feet 267

No Lines 4 Trench Width 36" Max Trench Bottom Depth 24" Gravel Depth 12"

☑ New System ☐ Repair System Type: I, II, III, IV, V, VI

System Description: Shallow gravity conventional

Repair System Description: Sensor

Maintenance Agreement Required: ☐ Yes ☑ No

☐ House/Mod. Home No. Bedrooms 2

☐ Mobile Home No. Bathrooms 1

☐ Business No. Employees ____

☐ Other _____


☐ Slab ☑ Crawl Space ☐ Basement w/plumbing ☐ Basement wo/plumbing

Water Supply: ☑ Individual ☐ Community ☐ Public

Comments: Laterals to be shallow - note max trench bottom depth on water to be supplied from Henry Chapman's well.

Comments:

INITIAL SITE SKETCH

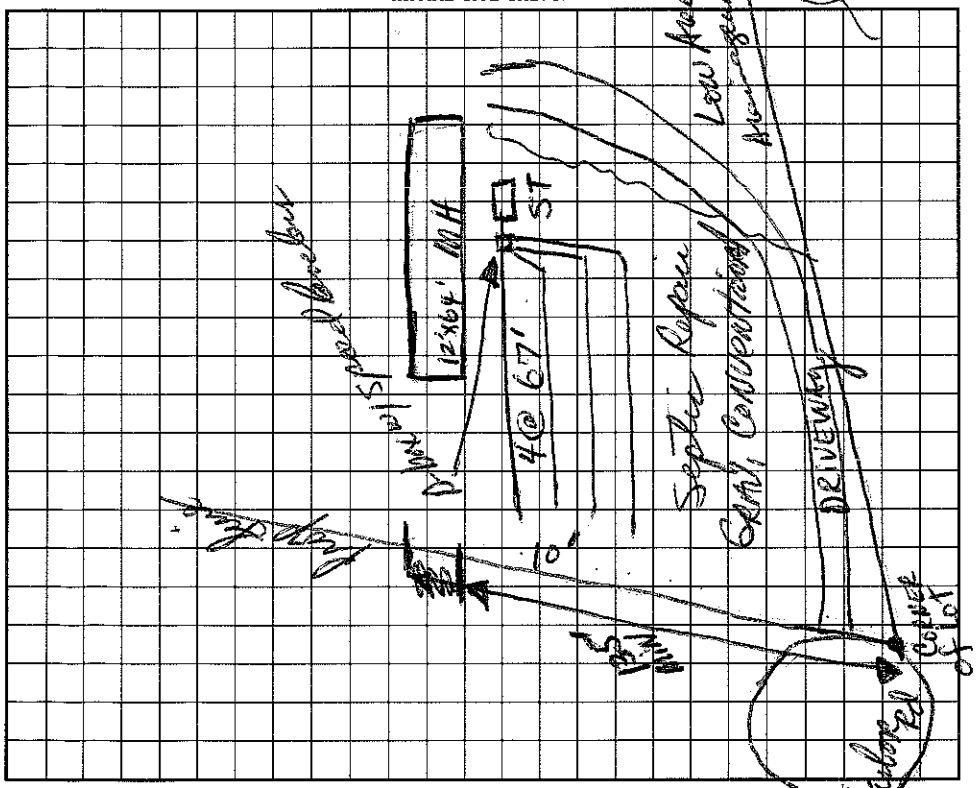

AS BUILT SKETCH

I understand that this permit can be suspended or revoked if any false information is supplied toward securing the permit/any unauthorized changes are made to the site/any unauthorized changes are made in the installation of the system. Improvement Permit is valid for 60 months from date of issuance.

Signed X Will Chapman

Improvement Permit by: [signature] REHS date 6-9-95

Existing System Inspection by: _____ date _____

Installed by: ABER NATHY

Certificate of Completion by: _____ date _____

Operation Permit by: [signature] REHS date 12/17/99

HEALTH DEPT. COPY: WHITE INSPECTION COPY (FINAL): GREEN OWNER COPY (FINAL): YELLOW INSPECTION COPY (INITIAL): PINK OWNER COPY (INITIAL): GOLD