IREDELL COUNTY HEALTH DEPARTMENT

STATESVILLE 704-878-5305 MOORESVILLE 704-664-5281

IMPROVEMENT PERMIT / AUTHORIZATION TO CONSTRUCT / OPERATION PERMIT / EXISTING SYSTEM INSPECTION

PERMIT# 19581 PIN# ~~4637166015.000~~ 4637-16-7024 DATE 7/30/04

OWNER OR CONTRACTOR McCRARY WOODS PARTNERS / Strawleaf Rd. PHONE: Business 799-9770 Home

ADDRESS PO BOX 3605 MOORESVILLE NC 28117

LOCATION 150 WEST - TL McCRARY ON RT

SUBDIVISION McCRARY WOODS BLOCK / SECTION 1 LOT 27 LOT AREA .88AC SITE CLASS. RS DESIGN FLOW 450GPD L.T.A.R. 30-PO/KR

Septic Tank: 1000 Gallons; STB 794 Date 11/21/05
Pump Tank: ____ Gallons; PT ____ Date ____
Pump Make: ____ Model ____ Serial No. ____
Nitrification Field: No Fields 1 Square Feet 1617 Linear Feet 539
No Lines 7@77' Trench Width 36" Max Trench Bottom Depth 36" Gravel Depth 12"

☑ New System ☐ Repair System Type: I, II, III, IV, V, VI
System Description: GRAVITY CONVENTIONAL
Repair System Description: GRAVITY 25% REDUCTION
Maintenance Agreement Required: ☐ Yes ☑ No LPP ANGLE


☑ ~~House/Mod. Home~~ No. Bedrooms 4
☐ Mobile Home No. Bathrooms 4
☑ ~~Business~~ No. Employees ____
☐ Other ____
☐ Slab ☑ Crawl Space ☐ Basement w/plumbing ☐ Basement wo/plumbing

Water Supply:
☑ ~~Individual~~
☐ Public
☐ Community


Comments:/Conditions:

Comments:/Conditions:

INITIAL SITE SKETCH 1"=50'

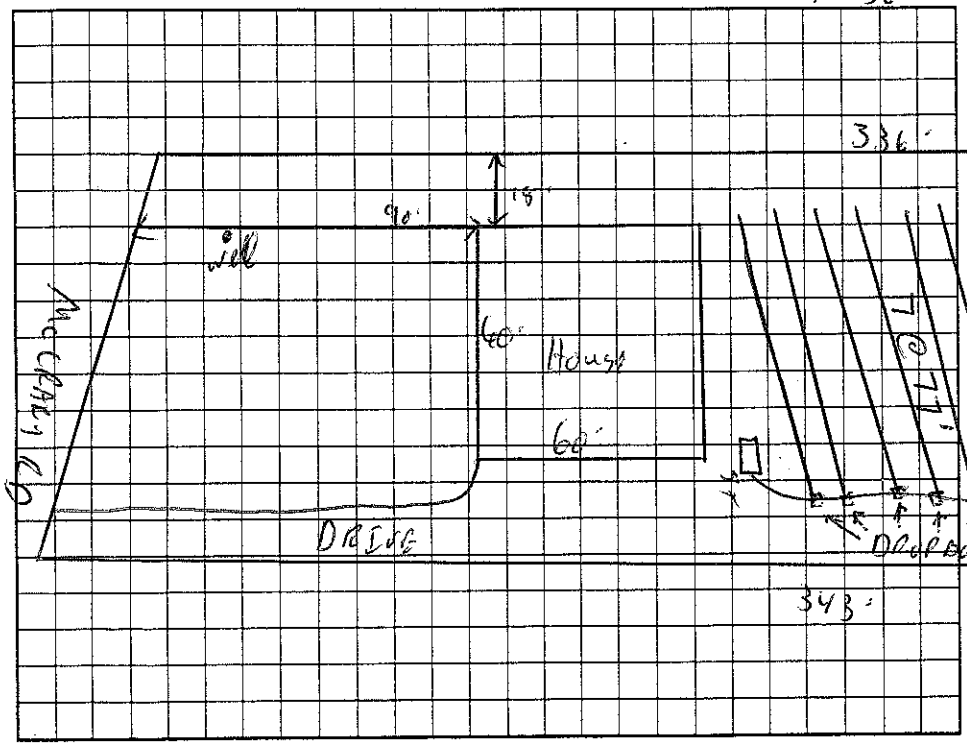

AS BUILT SKETCH

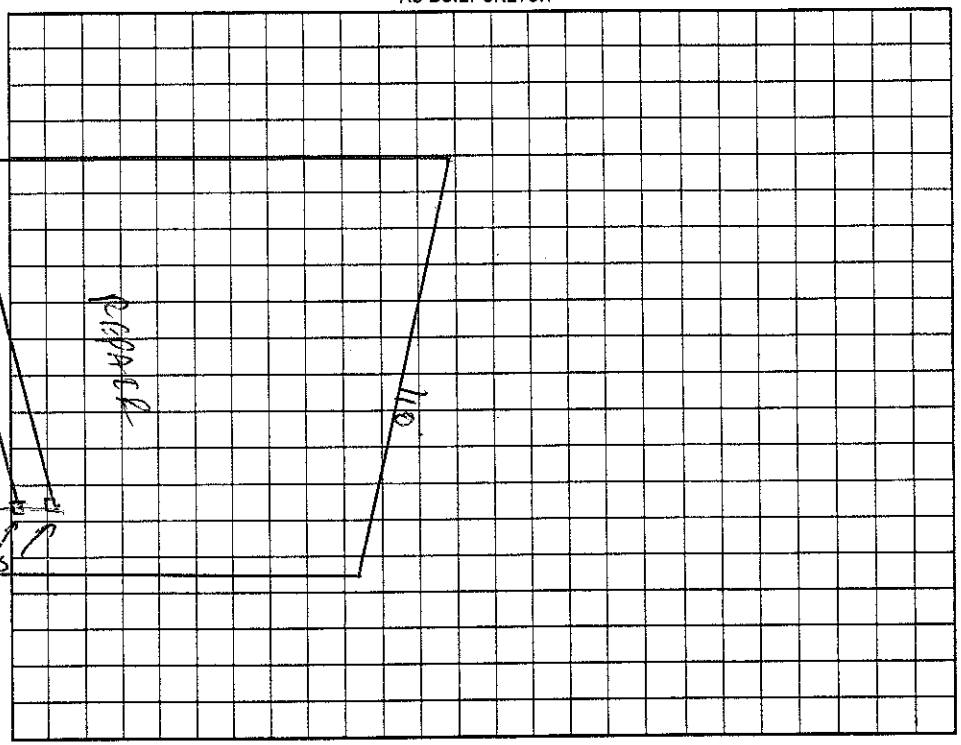

Permit can be suspended or revoked if any false information is supplied toward securing the permit/any unauthorized changes are made to the site/any unauthorized changes are made in the installation of the system. Improvement Permit ~~with plat~~ valid ~~without expiration~~. Improvement Permit with site plan valid for sixty months. Authorization to Construct is valid for a period equal to that of Improvement Permit – not to exceed sixty months.

Signed: ____ date 8-3-04 Installed by: Larry Beam

Improvement Permit by: ____ RS date 7/31/04 Operation Permit by: ____ RS date 2/16/06

Authorization to Construct by: ____ RS date 8/26/05 Existing System Inspection by: ____ date ____

HEALTH DEPT. COPY: WHITE OWNER COPY (FINAL): YELLOW OWNER COPY (INITIAL): PINK