IREDELL COUNTY HEALTH DEPARTMENT

STATESVILLE 704-878-5305 MOORESVILLE 704-664-5281

IMPROVEMENT PERMIT / AUTHORIZATION TO CONSTRUCT / OPERATION PERMIT / EXISTING SYSTEM INSPECTION

PERMIT# 106265 PIN# 4637173271 Max Jr. DATE 11-22-06

OWNER OR APPLICANT Spears Builders PHONE: Business 202-4964 Home

ADDRESS 172 Allendale Circle

LOCATION Hwy 150 West TL McCrary TR Hidden Harbor on right

SUBDIVISION Wilson Est BLOCK / SECTION LOT 4 LOT AREA 0.63 Acre SITE CLASS. PS DESIGN FLOW 450 gpd L.T.A.R. e 3

Septic Tank: 1000 Gallons; STB 825 Date 1-6-07
Pump Tank: 1000 Gallons; PT 302 Date 2-4-07
Pump Make: Zoeller Model N140 Serial No.
Nitrification Field: No Fields 1 Square Feet 560' Linear Feet 280'
No Lines 4@70' Trench Width 24" min Max Trench Bottom Depth 36" Gravel Depth N/A

[X] New System [ ] Repair [ ] Expansion System Type: I II III IV V VI
System Description: Pump - LP - Panel Blk
Repair System Description: Pump-LP-Panel Blk
Maintenance Agreement Required: [X] Yes [ ] No

[X] House/Mod. Home No. Bedrooms 4
[ ] Mobile Home No. Persons
[ ] Business No. Employees
[ ] Other


Water Supply: [X] Individual [ ] Public [ ] Community

[ ] Gravity [X] Pressure [ ] Slab [X] Crawl Space [ ] Basement w/plumbing [ ] Basement wo/plumbing

Comments:/Conditions: *Must keep Septic System at least 50ft to any well! *Use backfill to create slope to drain water away from house in front, otherwise 25ft setback to drain.

Comments:/Conditions: partial
Okay to install Septic in 3-90 lines if it will fit. Keep any future pool at least 15Ft From Septic System

INITIAL SITE SKETCH

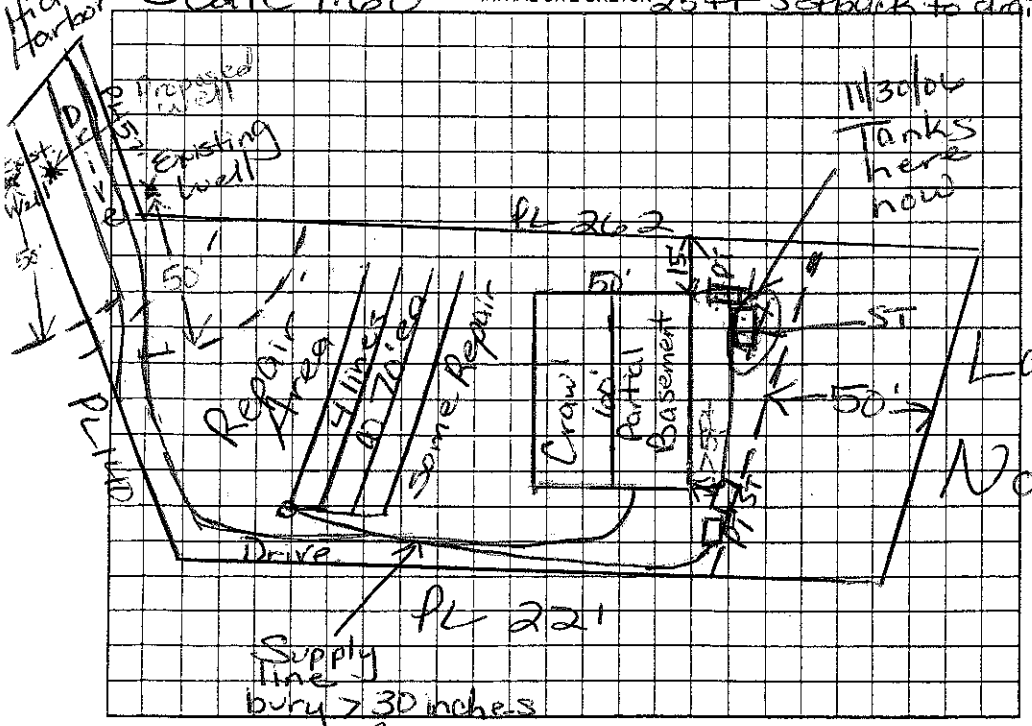

AS BUILT SKETCH

Reviewed plans, essentially in compliance with LPO
* Note: House 10Ft larger than original therefore No room for pool
Drilled 3/16" hole
Checked tanks & lines 3/23/07 mo

Permit can be suspended or revoked if any false information is supplied toward securing the permit/any unauthorized changes are made to the site/any unauthorized changes are made in the installation of the system. Improvement Permit with plat valid without expiration [ ] Improvement Permit with site plan valid for sixty months [ ] Authorization to Construct is valid for a period equal to that of Improvement Permit – not to exceed sixty months.

Signed: date 11/27/06 Installed by: Rowan Septic RS

Improvement Permit by: Maria H. Dolan RS date 11/22/06 Operation Permit by: Maria H. Dolan date 7/30/07

Authorization to Construct by: Maria H. Dolan RS date 11/30/06 Existing System Inspection by: date

HEALTH DEPT. COPY: WHITE OWNER COPY (FINAL): YELLOW OWNER COPY (INITIAL): PINK