IREDELL COUNTY HEALTH DEPARTMENT

STATESVILLE 704-878-5305 130.00 Paid MOORESVILLE 704-664-5281

IMPROVEMENT PERMIT / AUTHORIZATION TO CONSTRUCT / OPERATION PERMIT / EXISTING SYSTEM INSPECTION

PERMIT# 121296 PIN# 4637 18 6840

OWNER OR CONTRACTOR Bobby Graham DATE 6/6/04

ADDRESS 778 Fourth Rd. Mooresville PHONE: Business 664-0208 Home

LOCATION McCrary Rd. on R, 2nd driveway

SUBDIVISION Ne BLOCK / SECTION LOT LOT AREA ~ 10 Ac SITE CLASS. PS DESIGN FLOW 360 L.T.A.R. .3

Septic Tank: 1000 Gallons; STB 875 Date 5/30/04

Pump Tank: Gallons; PT Date

Pump Make: Model Serial No.

Nitrification Field: No Fields 1 Square Feet 900 Linear Feet 300

No Lines 4@75' Trench Width 3' Max Trench Bottom Depth 30" Gravel Depth No

☒ New System ☐ Repair System Type: I, II, (III), IV, V, VI

System Description: County - Typ 3

Repair System Description: Same

Maintenance Agreement Required: ☐ Yes ☒ No

☒ House/Mod. Home No. Bedrooms 3

☐ Mobile Home No. Bathrooms 2

☐ Business No. Employees

☐ Other

☐ Slab ☒ Crawl Space ☐ Basement w/plumbing ☐ Basement wo/plumbing

Water Supply: ☒ Individual ☐ Public ☐ Community


Comments:/Conditions:

Some Repair


Comments:/Conditions: Standard dog leg trench installed as shown on AC.

1" = 50'

INITIAL SITE SKETCH

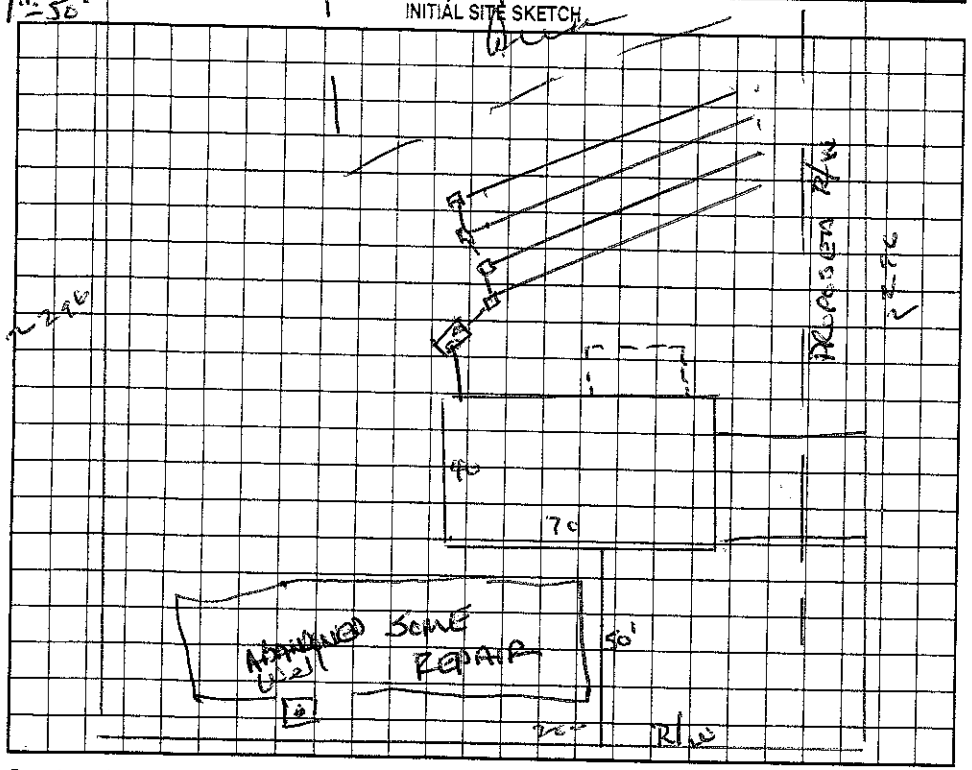

AS BUILT SKETCH

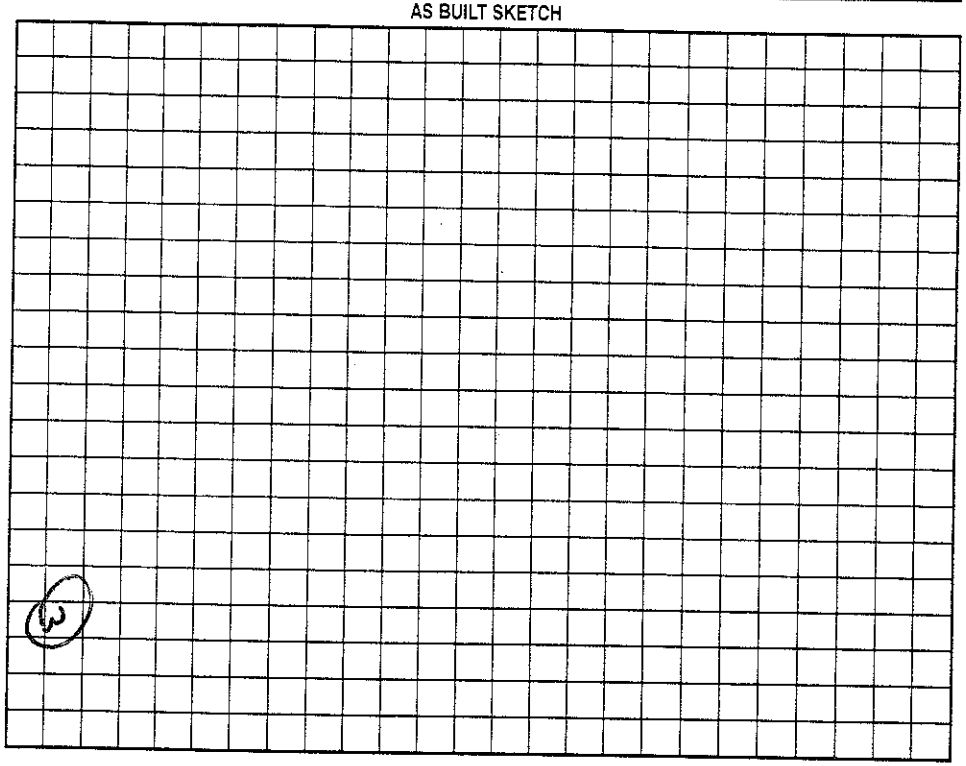

Permit can be suspended or revoked if any false information is supplied toward securing the permit/any unauthorized changes are made to the site/any unauthorized changes are made in the installation of the system. Improvement Permit with plat valid without expiration. Improvement Permit with site plan valid for sixty months. Authorization to Construct is valid for a period equal to that of Improvement Permit – not to exceed sixty months.

Signed: X Bobby Graham date 6-7-4

Improvement Permit by: Wesley Sparks RS date 6/6/04

Authorization to Construct by: Wesley Sparks RS date 6/6/04

Installed by: Joe Thompson

Operation Permit by: Wesley Sparks RS date 8/5/04

Existing System Inspection by: date

HEALTH DEPT. COPY: WHITE OWNER COPY (FINAL): YELLOW OWNER COPY (INITIAL): PINK