Chuck Mayer

IREDELL COUNTY HEALTH DEPARTMENT

STATESVILLE 704-878-5305 MOORESVILLE 704-664-5281

IMPROVEMENT PERMIT / AUTHORIZATION TO CONSTRUCT / OPERATION PERMIT / EXISTING SYSTEM INSPECTION

PERMIT# 077511 PIN# 4637 19 0941 DATE 12/11/98

OWNER OR CONTRACTOR Thomas McCoy (Birmingham Bros.) PHONE: Business 892-7010 Home

ADDRESS 156 Wades Way Mooresville, NC. 28115

LOCATION Hwy 150 W on R just before B-P (Market Basket)

SUBDIVISION No BLOCK / SECTION No LOT No LOT AREA ~5.1 AC SITE CLASS. PS DESIGN FLOW 100 GPD L.T.A.R. .3

Septic Tank: 1000 Gallons; STB 794 Date

Pump Tank: 1000 Gallons; PT 27 Date

Pump Make: NEOS III HH Model Goulds Serial No. L9834184

Nitrification Field: No Fields 1 Square Feet 333 Linear Feet 111

No Lines 2 Trench Width 36" Max Trench Bottom Depth 32" Gravel Depth 12"

☒ New System ☐ Repair System Type: I, II, ☒ III, IV, V, VI

System Description: Pres. Manifold - Conventional

Repair System Description: None

Maintenance Agreement Required: ☐ Yes ☒ No

☒ House/Mod. Home No. Bedrooms

☐ Mobile Home No. Bathrooms

☒ Business No. Employees 2

☒ Other OFFICE


☒ Slab ☐ Crawl Space ☐ Basement w/plumbing ☐ Basement wo/plumbing

Water Supply: ☒ Individual ☐ Public ☐ Community


Comments:/Conditions:

Comments:/Conditions:

INITIAL SITE SKETCH

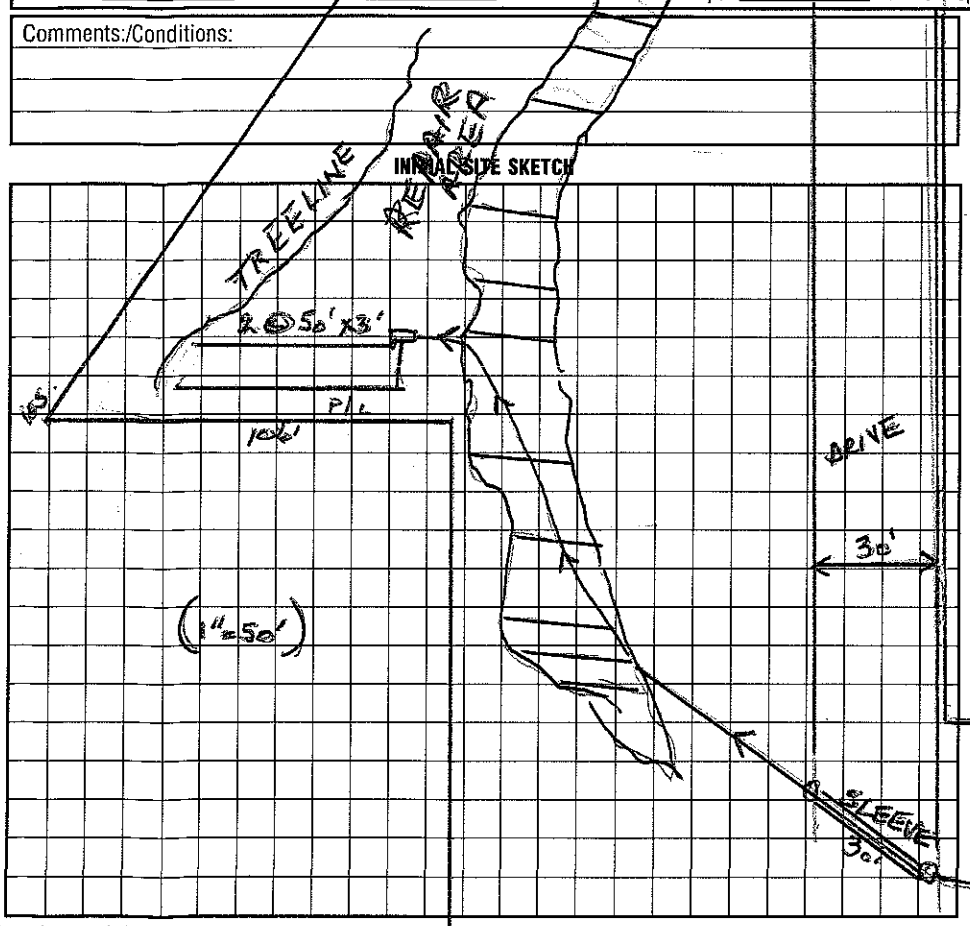

AS BUILT SKETCH

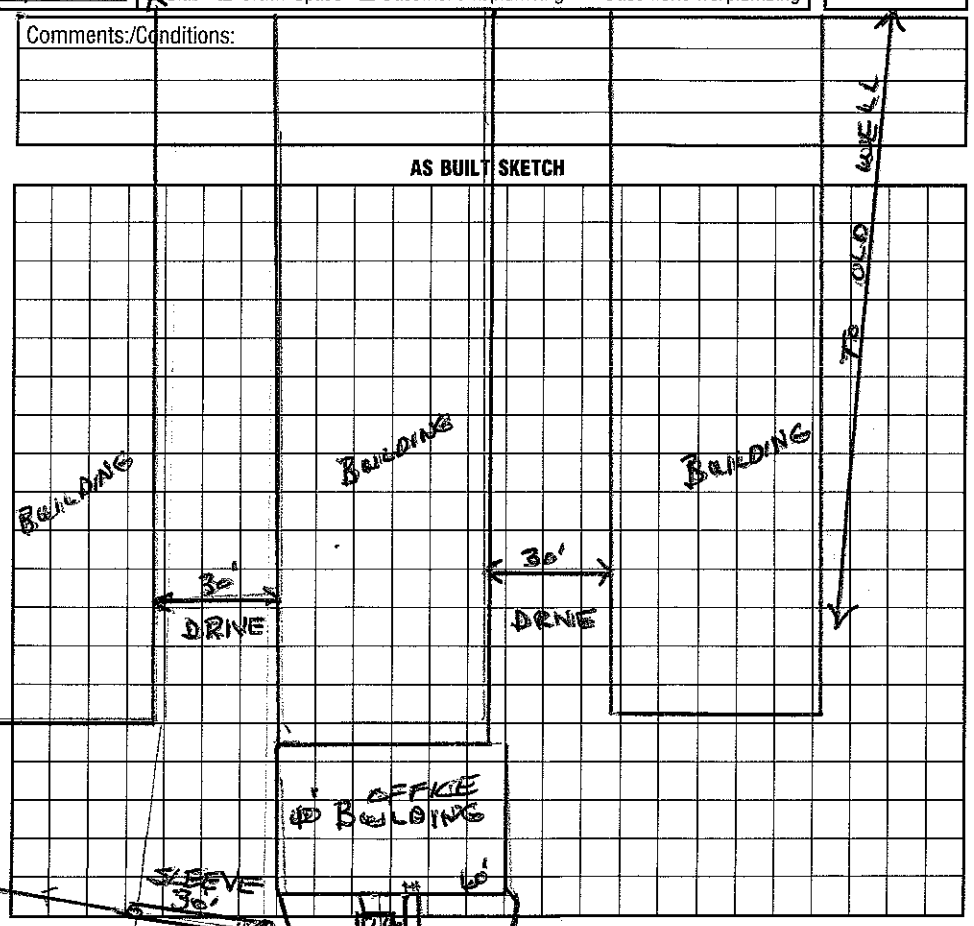

I understand that this permit can be suspended or revoked if any false information is supplied toward securing the permit/any unauthorized changes are made to the site any unauthorized changes are made in the installation of the system. Improvement Permit with plat valid without expiration. Improvement Permit with site plan valid for sixty months. Authorization to Construct is valid for a period equal to that of Improvement Permit – not to exceed sixty months.

Signed: Joel Birmingham date 12/15/98 Installed by: Chuck Mayer

Improvement Permit by: Wesley Sparks R.S. date 12/11/98 Operation Permit by: Wesley Sparks R.S. date 3/18/99

Authorization to Construct by: Wesley Sparks R.S. date 12/11/98 Existing System Inspection by: date

HEALTH DEPT. COPY: WHITE INSPECTION COPY (FINAL): GREEN OWNER COPY (FINAL): YELLOW INSPECTION COPY (INITIAL): PINK OWNER COPY (INITIAL): GOLD