As Built drawing

IREDELL COUNTY HEALTH DEPARTMENT

STATESVILLE 704-878-5305 MOORESVILLE 704-664-5281

IMPROVEMENT PERMIT / AUTHORIZATION TO CONSTRUCT / OPERATION PERMIT / EXISTING SYSTEM INSPECTION

PERMIT# 100272 PIN# ~~4637214601 pt~~ 4637-21-1731 DATE 9-24-02

OWNER OR CONTRACTOR Edwards Construction PHONE: Business _____ Home _____

ADDRESS 2419 Henry Baycom Rd Monroe NC 28110

LOCATION Brawley School Rd TR Blume on right

SUBDIVISION Devonshire BLOCK / SECTION _____ LOT 8 LOT AREA .74 Acre SITE CLASS. PS DESIGN FLOW 480gpd L.T.A.R. _____

Septic Tank: 1000 Gallons; STB 794 Date _____

Pump Tank: _____ Gallons; PT _____ Date _____

Pump Make: _____ Model _____ Serial No. _____

Nitrification Field: No Fields 1 Square Feet 1200 Linear Feet 400

No Lines 5@80' Trench Width 36" Max Trench Bottom Depth 36" Gravel Depth N/A

☒ New System ☐ Repair System Type: I, II, III, IV, V, VI

System Description Gravity-25% Reduction

Repair System Description: Pump - Innovative

Maintenance Agreement Required: ☐ Yes ☐ No

☒ House/Mod. Home No. Bedrooms 4

☐ Mobile Home No. Bathrooms 2.5

☐ Business No. Employees _____

☐ Other _____


☐ Slab ☒ Crawl Space ☐ Basement w/plumbing ☐ Basement wo/plumbing

Water Supply: ☒ Individual ☐ Public ☐ Community

Comments/Conditions:

Comments/Conditions: Installed "EZ Flow" for Drainfield

Scale 1:50 INITIAL SITE SKETCH

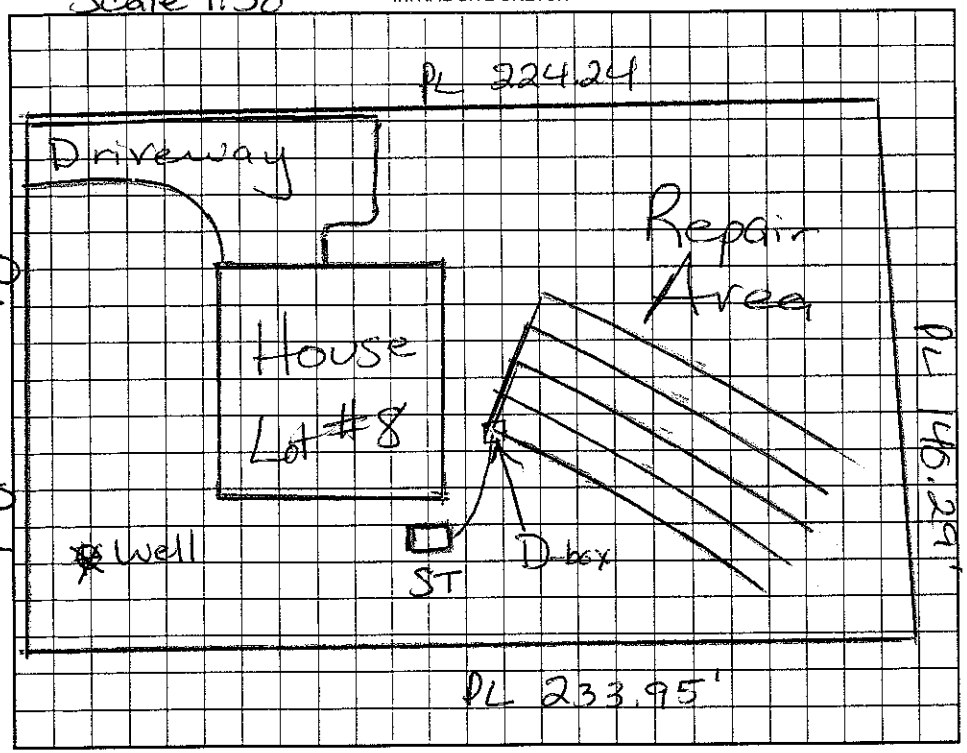

AS BUILT SKETCH

Permit can be suspended or revoked if any false information is supplied toward securing the permit/any unauthorized changes are made to the site/any unauthorized changes are made in the installation of the system. Improvement Permit with plat valid without expiration. Improvement Permit with site plan valid for sixty months. Authorization to Construct is valid for a period equal to that of Improvement Permit – not to exceed sixty months.

Signed: _____ date _____ Installed by: Richard Abernathy

Improvement Permit by: Maina H. Dotson RS date 9/24/02 Operation Permit by: Maina H. Dotson RS date 9/24/02

Authorization to Construct by: Maina H. Dotson RS date 9/24/02 Existing System Inspection by: _____ date _____

HEALTH DEPT. COPY: WHITE OWNER COPY (FINAL): YELLOW OWNER COPY (INITIAL): PINK

IREDELL COUNTY HEALTH DEPARTMENT

STATESVILLE 704-878-5305 175.00 Paid MOORESVILLE 704-664-5281

IMPROVEMENT PERMIT / AUTHORIZATION TO CONSTRUCT / OPERATION PERMIT / EXISTING SYSTEM INSPECTION

PERMIT# 100272 PIN# 4637 14601 (pt) DATE June 20, 01

OWNER OR CONTRACTOR Blume Road Partners // Edwards Const. Inc PHONE: Business _____ Home _____

ADDRESS 149 Locust Cove Mooresville 28117

LOCATION Brawley School Rd TR Blume on Right

SUBDIVISION Devonshire BLOCK / SECTION _____ LOT 3 LOT AREA ± 1 Ac SITE CLASS. 45 DESIGN FLOW 480 gpd L.T.A.R. .3

Septic Tank: 1000 Gallons; STB 794 Date 6-16-02

Pump Tank: _____ Gallons; PT _____ Date _____

Pump Make: _____ Model _____ Serial No. _____

Nitrification Field: No Fields 1 Square Feet 1200 Linear Feet 400

No Lines 4 @ 100'± Trench Width 36" Max Trench Bottom Depth 36" Gravel Depth NA

☑ New System ☐ Repair System Type: I, II, III, IV, V, VI

System Description: Gravity Conventional -25% Red.

Repair System Description: LP Transmitter PPBPS

Maintenance Agreement Required: ☐ Yes ☑ No initially

☑ House/Mod. Home ☐ Mobile Home ☐ Business ☐ Other

No. Bedrooms 4 No. Bathrooms 4 No. Employees ____


☐ Slab ☑ Crawl Space ☐ Basement w/plumbing ☐ Basement wo/plumbing

Water Supply: ☐ Individual ☐ Public ☐ Community

Comments:/Conditions: Maintain 100' minimum separation between well & Septic System.

Comments:/Conditions: Installed filter Drive on other side

INITIAL SITE SKETCH

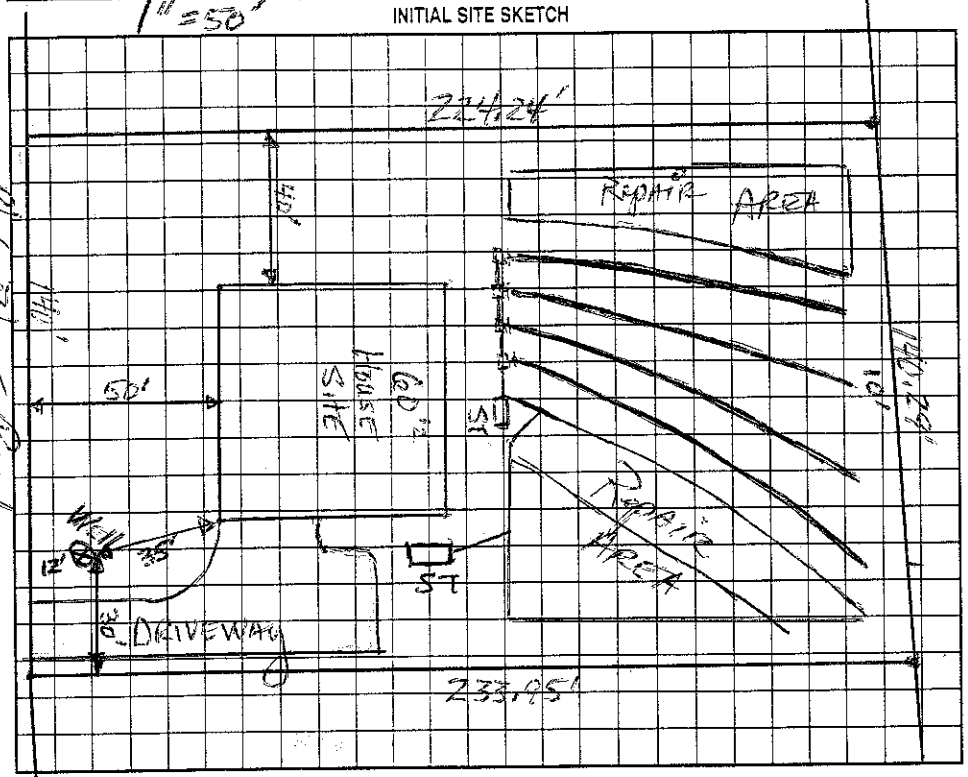

AS BUILT SKETCH

See attached "As Built" permit

Installed EZ Flow Drainfield

50 @ 80'

used Dist. box

Permit can be suspended or revoked if any false information is supplied toward securing the permit/any unauthorized changes are made to the site/any unauthorized changes are made in the installation of the system. Improvement Permit with plat valid without expiration. Improvement Permit with site plan valid for sixty months. Authorization to Construct is valid for a period equal to that of Improvement Permit – not to exceed sixty months.

Signed: _____ date 6-21-01 Installed by: Richard Abernathy

Improvement Permit by: _____ date 6-20-01 Operation Permit by: _____ date _____

Authorization to Construct by: _____ date 5-23-02 Existing System Inspection by: _____ date _____

HEALTH DEPT. COPY: WHITE OWNER COPY (FINAL): YELLOW OWNER COPY (INITIAL): PINK