IREDELL COUNTY HEALTH DEPARTMENT

STATESVILLE 704-878-5305 MOORESVILLE 704-664-5281

IMPROVEMENT PERMIT / AUTHORIZATION TO CONSTRUCT / OPERATION PERMIT / EXISTING SYSTEM INSPECTION

PERMIT# 100456 PIN# 4637214601 (Lot) DATE June 28, 01

OWNER OR CONTRACTOR Blume Road Partners // Edwards Const Inc PHONE: Business (704) 363-3173 Home

ADDRESS 199 Yacht Cove Rd. Mooresville NC 28117 // 2419 Henry Baucom Rd. Monroe N.C. 28110

LOCATION Brawley Sch Rd. TR Blume TR Patterson on Right

SUBDIVISION Devonshire BLOCK // SECTION LOT 35 LOT AREA .78Ac SITE CLASS PS DESIGN FLOW 460gpd L.T.A.R. .03

Septic Tank: 1000 Gallons: STB 1612 Date

Pump Tank: 1000 Gallons: PT 17 Date 2/13/02

Pump Make: E-One Model QEH Serial No.

Nitrification Field: No Fields 1 Square Feet 1200 Linear Feet 400

No Lines 3 Trench Width 36" Max Trench Bottom Depth 36" Gravel Depth NA

☑ New System ☐ Repair System Type: I, II, III, IV, V, VI

System Description: PM - Innovative 25% Red

Repair System Description: PM / LP Innovative

Maintenance Agreement Required: ☐ Yes ☑ No initially

☑ House/Mod. Home ☐ Mobile Home ☐ Business ☐ Other

No. Bedrooms 4 No. Bathrooms 4 No. Employees

☐ Slab ☑ Crawl Space ☐ Basement w/plumbing ☐ Basement wo/plumbing


Water Supply: ☑ Individual ☐ Public ☐ Community

Comments:/Conditions:


10-3-01 Reviewed house plan; Appears in compliance DH

Comments:/Conditions:

INITIAL SITE SKETCH 1"=50'

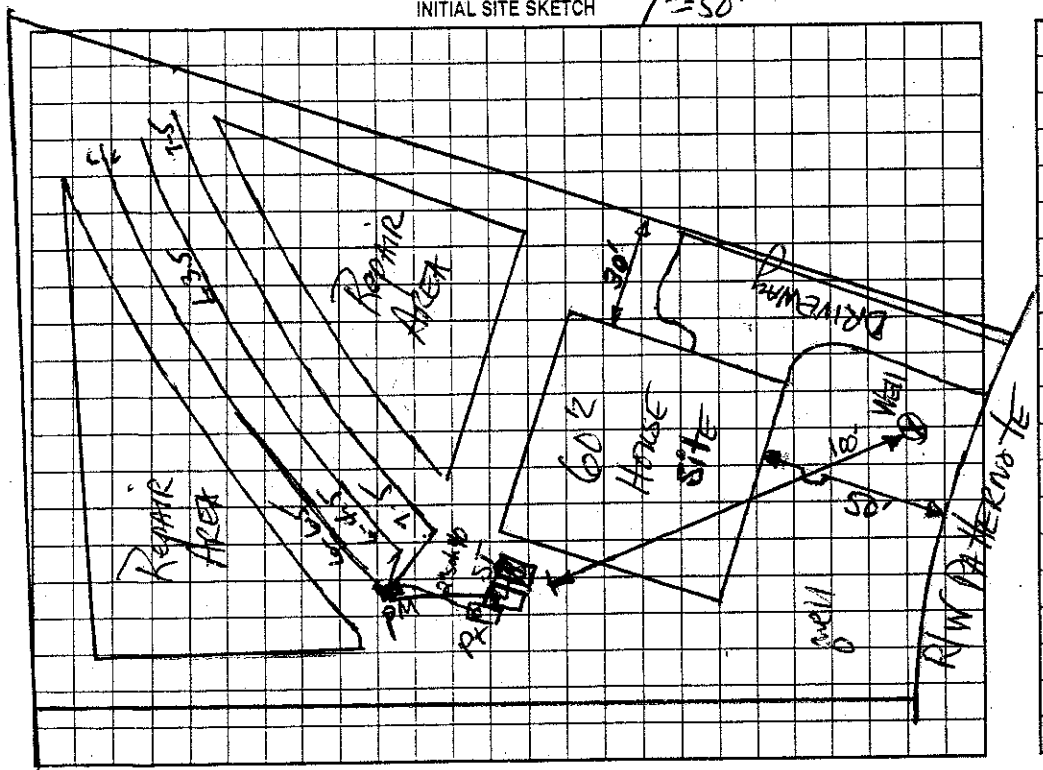

AS BUILT SKETCH

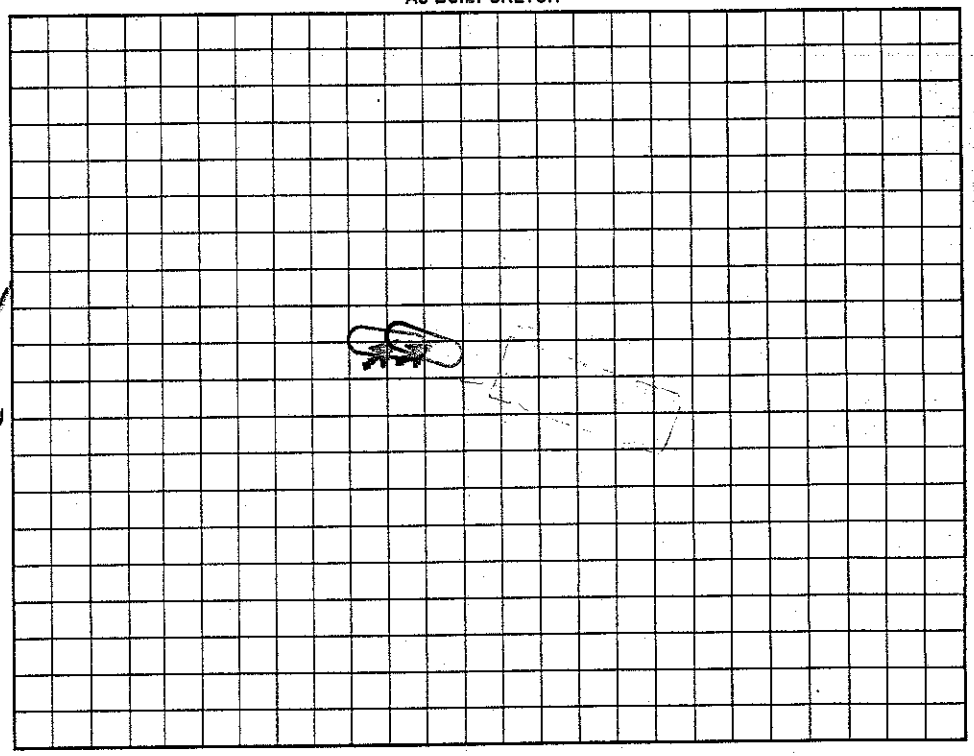

Permit can be suspended or revoked if any false information is supplied toward securing the permit/any unauthorized changes are made to the site/any unauthorized changes are made in the installation of the system. Improvement Permit with plat valid without expiration. Improvement Permit with site plan valid for sixty months. Authorization to Construct is valid for a period equal to that of Improvement Permit – not to exceed sixty months.

Signed: date 7.17.01 Installed by: Richard Abernethy

Improvement Permit by: date 6-28-01 Operation Permit by: date 8/1/02

Authorization to Construct by: date 10-3-01 Existing System Inspection by: date

HEALTH DEPT. COPY: WHITE OWNER COPY (FINAL): YELLOW OWNER COPY (INITIAL): PINK