3.

IREDELL COUNTY HEALTH DEPARTMENT

STATESVILLE 704-878-5305 MOORESVILLE 704-664-5281

IMPROVEMENT PERMIT / AUTHORIZATION TO CONSTRUCT / OPERATION PERMIT / EXISTING SYSTEM INSPECTION

PERMIT# 100366 PIN# 4639-21-4601 (pt.) 4637214909 DATE June 27, 01

OWNER OR CONTRACTOR Blume Road Partners // Edwards Const Inc PHONE: Business (704) 363-3713 Home

ADDRESS 149 Yacht Cove Rd. Mooresville NC 28117 // 2419 Henry Bascom Rd. Monroe NC 28110

LOCATION Brawley Sch Rd TR Blume Rd TR Patterson Rd on Right

SUBDIVISION Devonshire BLOCK / SECTION LOT 33 LOT AREA .92Ac SITE CLASS. PS DESIGN FLOW 460gpd L.T.A.R. .3

Septic Tank: 1000 Gallons; STB 1010 Date 3-3-02

Pump Tank: 1000 Gallons; PT 17 Date 1-20-02

Pump Make: Little Giant Model Serial No.

Nitrification Field: No Fields 1 Square Feet 540/810 Linear Feet 270

No Lines 3 Trench Width 24" min 86c Max Trench Bottom Depth 36" Gravel Depth NA

☑ New System ☐ Repair System Type: I, II, III, IV, V, VI

System Description: LPPPBPS

Repair System Description: SAME

Maintenance Agreement Required: ☑ Yes ☐ No

☐ House/Mod. Home No. Bedrooms 4

☐ Mobile Home No. Bathrooms 4

☐ Business No. Employees

☐ Other

☐ Slab ☑ Crawl Space ☐ Basement w/plumbing ☐ Basement wo/plumbing

Water Supply: ☑ Individual ☐ Public ☐ Community

Comments:/Conditions:


10-03-01 Reviewed house plan; appears in compliance PRH

or 36" max 96c

Comments:/Conditions:

INITIAL SITE SKETCH

1"=50'

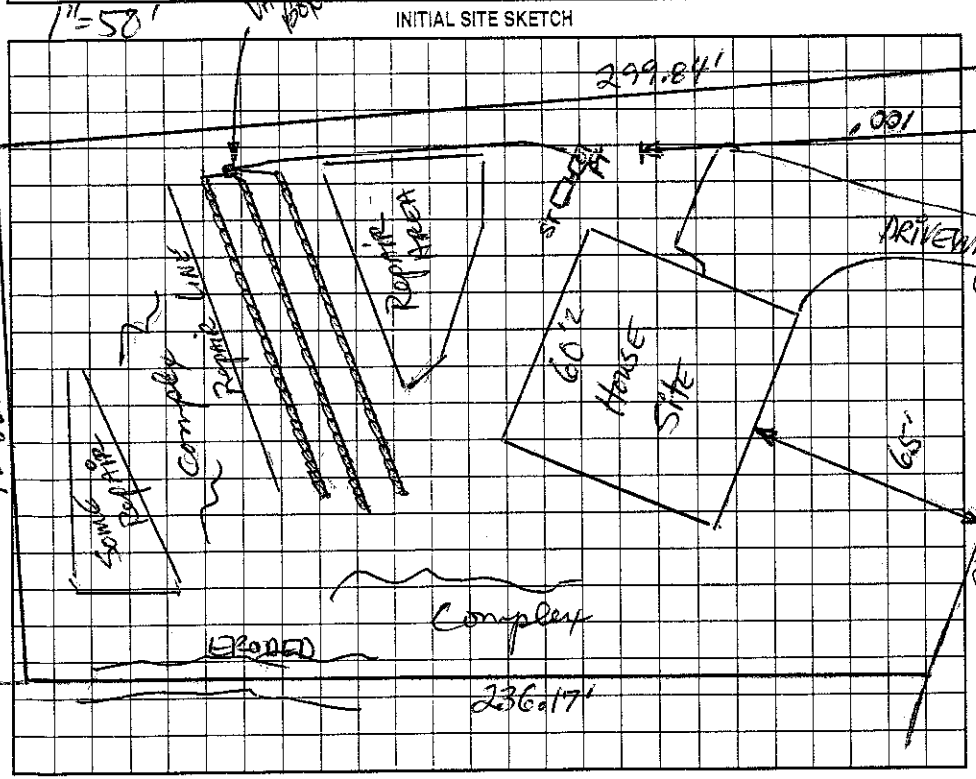

AS BUILT SKETCH

Installed as Drawn

Panel Block Drainfield

Permit can be suspended or revoked if any false information is supplied toward securing the permit/any unauthorized changes are made to the site/any unauthorized changes are made in the installation of the system. Improvement Permit with plat valid without expiration. Improvement Permit with site plan valid for sixty months. Authorization to Construct is valid for a period equal to that of Improvement Permit – not to exceed sixty months.

Signed: date 7.17.01

Improvement Permit by: RS date 6-27-01

Authorization to Construct by: RS date 10-03-01

Installed by: Richard Abernathy

Operation Permit by: RS date 5/03/02

Existing System Inspection by: date

HEALTH DEPT. COPY: WHITE OWNER COPY (FINAL): YELLOW OWNER COPY (INITIAL): PINK