IREDELL COUNTY HEALTH DEPARTMENT

STATESVILLE 704-878-5305 MOORESVILLE 704-664-5281

IMPROVEMENT PERMIT / AUTHORIZATION TO CONSTRUCT / OPERATION PERMIT / EXISTING SYSTEM INSPECTION

PERMIT# 142326 PIN# 4637 21 5580 DATE 11/28/07

OWNER OR APPLICANT Heritage Homes PHONE: Business 980-722-7370 Home

ADDRESS PO Box 3333 Mooresville, NC. 28115

LOCATION 1100 TR Blum Rd. TR Patterson Rd. ~ .9 mile on R - 244 Patterson Rd.

SUBDIVISION Devonshire BLOCK / SECTION LOT 37 LOT AREA ~ .7Ac SITE CLASS. PS DESIGN FLOW 480 L.T.A.R. - 3

Septic Tank: 1000V Gallons: STB 794 Date 3/11/08

Pump Tank: 1000V Gallons: PT 318 Date 12/18/06

Pump Make: Little Giant Model ME-N 14 Serial No.

Nitrification Field: No Fields 1 Square Feet 810 Linear Feet 270

No Lines 3@90' Trench Width 2-3' Max Trench Bottom Depth 3'

[X] New System [ ] Repair [ ] Expansion System Type: I II III [IV] V VI

System Description: Presson Bond - 16" PPBPS

Repair System Description: SAME TYPE

Maintenance Agreement Required: [X] Yes [ ] No

[X] House/Mod. Home No. Bedrooms 4

[ ] Mobile Home No. Persons

[ ] Business No. Employees

[ ] Other


Water Supply: [X] Individual [ ] Public [ ] Community

Gravel Depth No [ ] Gravity [X] Pressure [ ] Slab [ ] Crawl Space [X] Basement w/plumbing [ ] Basement wo/plumbing


Comments:/Conditions (1) 3/16 holes ONE PER PANEL TURNED UP (2) 2" MINIMUM PRESSURE IN DRAINLINES (3) SIMTECH FILTER REQUIRED (4) 62 PANELS - 27' TDH - 37 GPM MINIMUM PUMP SPECS

Comments:/Conditions: 3/16"

INITIAL SITE SKETCH (1" = 50')

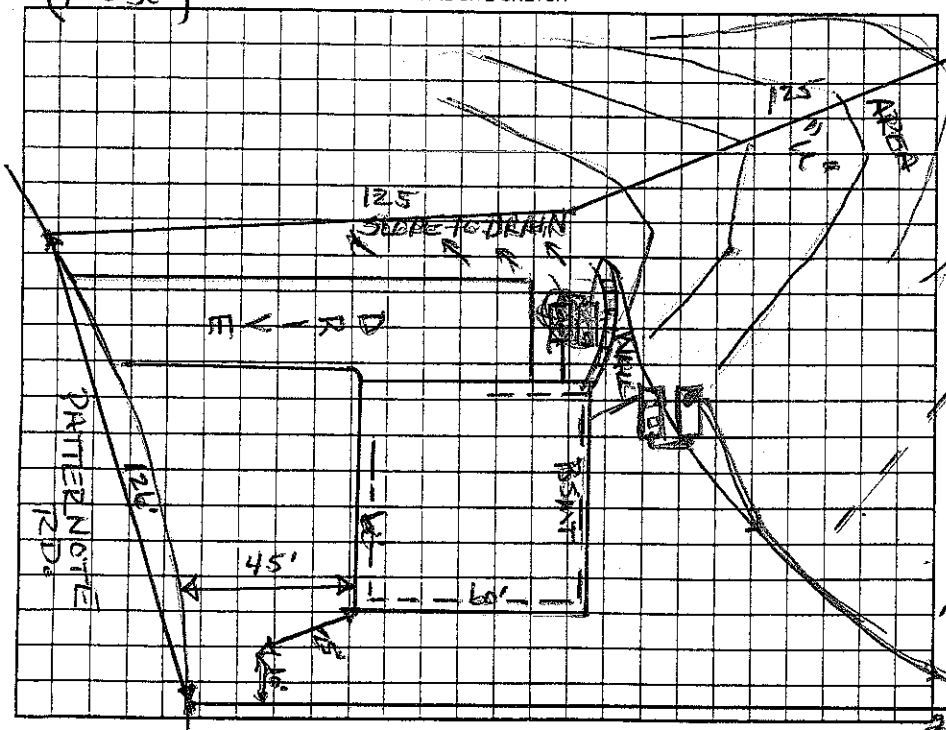

AS BUILT SKETCH

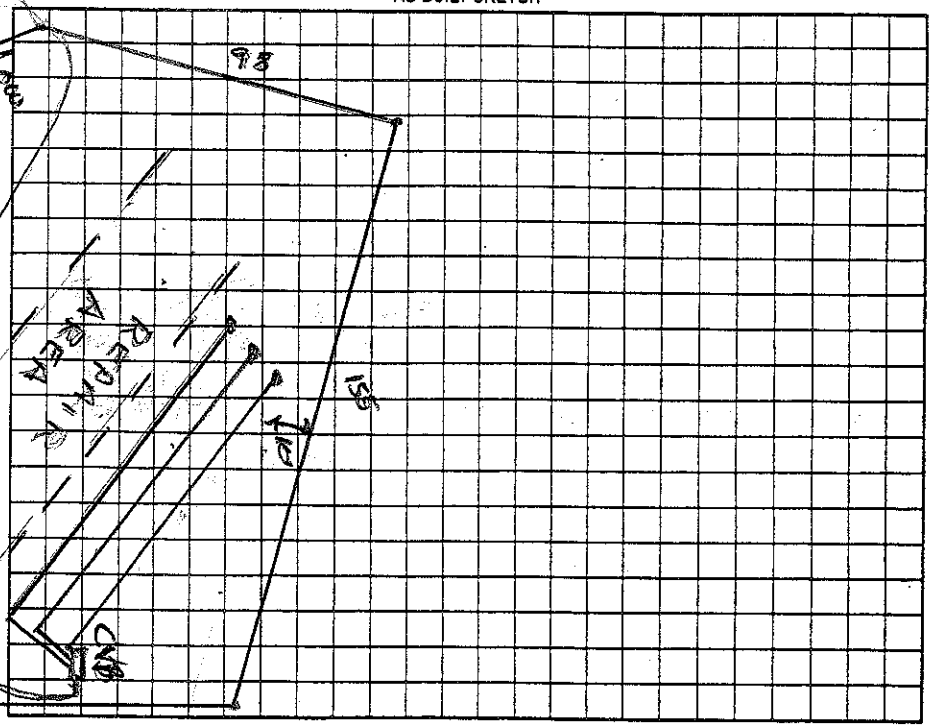

Permit can be suspended or revoked if any false information is supplied toward securing the permit/any unauthorized changes are made to the site/any unauthorized changes are made in the installation of the system. Improvement Permit with plat valid without expiration [ ] Improvement Permit with site plan valid for sixty months [X] Authorization to Construct is valid for a period equal to that of Improvement Permit – not to exceed sixty months.

Signed: X [illegible] date 11-28-07 Installed by: Piedmont Septic Tank

Improvement Permit by: Wesley Sparks R.S. date 11/28/07 Operation Permit by: Wesley Sparks R.S. date 7/18/08

Authorization to Construct by: Wesley Sparks R.S. date 11/28/07 Existing System Inspection by: date

HEALTH DEPT. COPY: WHITE OWNER COPY (FINAL): YELLOW OWNER COPY (INITIAL): PINK