2500

IREDELL COUNTY HEALTH DEPARTMENT

STATESVILLE 704-878-5305 MOORESVILLE 704-664-5281

IMPROVEMENT PERMIT / AUTHORIZATION TO CONSTRUCT / OPERATION PERMIT / EXISTING SYSTEM INSPECTION

PERMIT# 100268 PIN# 4637-21-~~7198~~ 9198 DATE 10/19/01

OWNER OR CONTRACTOR Blume Road Partners / The Dupont Group PHONE: Business 704 660 0802 Home

ADDRESS 149 Yacht Cove Mooresville NC 28117

LOCATION Brawley Sch, TR Blume on Rt at Devonshire Sign

SUBDIVISION Devonshire BLOCK / SECTION LOT 1 LOT AREA 2.95 AC SITE CLASS. 95 DESIGN FLOW 600 L.T.A.R. 0.5

Septic Tank: 1500 Gallons; STB # 1011 Date 4/7/01

Pump Tank: Gallons; PT Date

Pump Make: Model Serial No.

Nitrification Field: No Fields 1 Square Feet 1500 Linear Feet 500'

No Lines #4@125' Trench Width 36" Max Trench Bottom Depth 36" Gravel Depth —

☒ New System ☐ Repair System Type: I, II, (III), IV, V, VI

System Description: Gravity 25% Reduction

Repair System Description: Similar

Maintenance Agreement Required: ☐ Yes ☒ No

☒ House/Mod. Home No. Bedrooms 5

☐ Mobile Home No. Bathrooms 4½

☐ Business No. Employees

☐ Other

☐ Slab ☐ Crawl Space ☒ Basement w/plumbing ☐ Basement wo/plumbing

Water Supply: ☒ Individual ☐ Public ☐ Community


Comments:/Conditions:

Comments:/Conditions:

The house will slide to the Right 30' - No effect on drain field.

1" = 100'

INITIAL SITE SKETCH

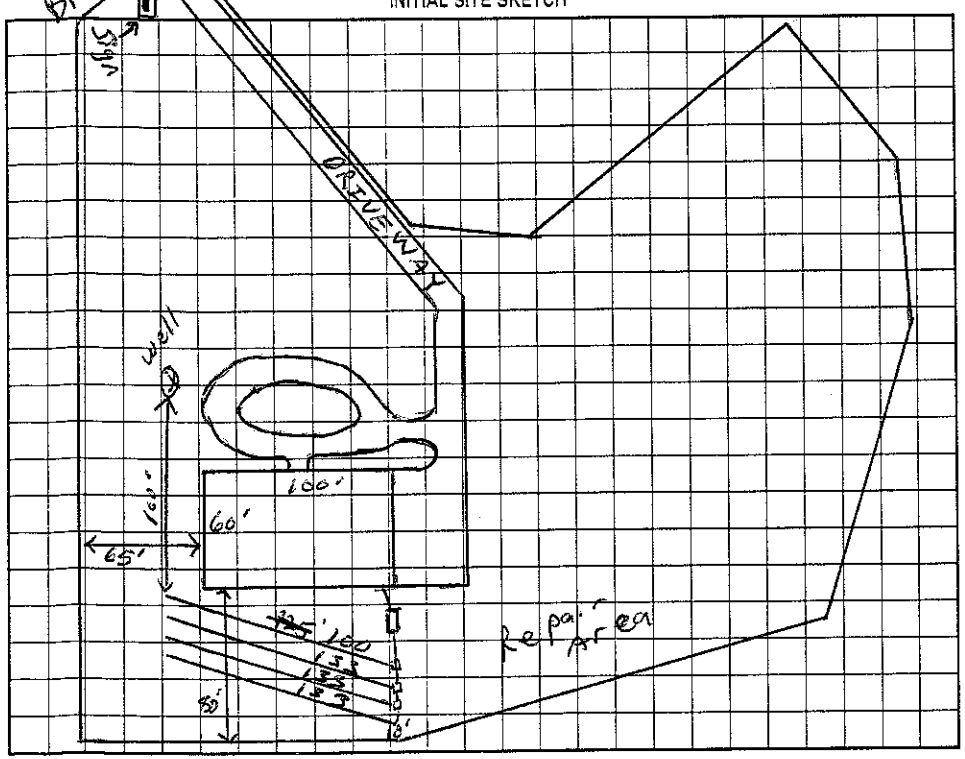

AS BUILT SKETCH

Permit can be suspended or revoked if any false information is supplied toward securing the permit/any unauthorized changes are made to the site/any unauthorized changes are made in the installation of the system. Improvement Permit with plat valid without expiration. Improvement Permit with site plan valid for sixty months. Authorization to Construct is valid for a period equal to that of Improvement Permit – not to exceed sixty months.

Signed: date 10-22-01 Installed by: Richard Abernathy

Improvement Permit by: RST date 10/22/01 Operation Permit by: RS date 7/19/02

Authorization to Construct by: RST date 12/17/01 Existing System Inspection by: date

HEALTH DEPT. COPY: WHITE OWNER COPY (FINAL): YELLOW OWNER COPY (INITIAL): PINK