IREDELL COUNTY HEALTH DEPARTMENT

STATESVILLE 704-878-5305 MOORESVILLE 704-664-5281

IMPROVEMENT PERMIT / AUTHORIZATION TO CONSTRUCT / OPERATION PERMIT / EXISTING SYSTEM INSPECTION

PERMIT# 100363 PIN# 4637214601 (pt) 4637221487 DATE 4-15-03

OWNER OR CONTRACTOR Blume Road Partners/Edwards Const. PHONE: Business (704)363-3713 Home

ADDRESS 2419 Henry Baucom Rd. Monroe, NC 28110

LOCATION Brawley School TR Blume Rd TR Patternote Rd approximately 3/10 mile on right

SUBDIVISION Devonshire BLOCK / SECTION LOT 28 LOT AREA .98 acre SITE CLASS. PS DESIGN FLOW 360gpd L.T.A.R. .3

Septic Tank: 1000 Gallons; STB 794 Date 2-6-03
Pump Tank: 1000 Gallons; PT 27 Date 2-26-03
Pump Make: Little Giant Model 9E H Serial No.
Nitrification Field: No Fields 1 Square Feet 900' Linear Feet 300'
No Lines 5@60' Trench Width 36" Max Trench Bottom Depth 36" Gravel Depth N/A

[X] New System [ ] Repair System Type: I, II, (III) IV, V, VI
System Description: Pump(PM) 25% Reduction
Repair System Description: LP Panel Block
Maintenance Agreement Required: [ ] Yes [X] No


[X] House/Mod. Home No. Bedrooms 3
[ ] Mobile Home No. Bathrooms 3
[ ] Business No. Employees
[ ] Other
[ ] Slab [X] Crawl Space [ ] Basement w/plumbing [ ] Basement wo/plumbing

Water Supply: [X] Individual [ ] Public [ ] Community


Comments:/Conditions: Keep Septic System at least 10' From PL & 50-100' From any well. Stay at least 15' from Cut 2' or greater.

Comments:/Conditions: Checked tanks & lines 4/17/03 MD

INITIAL SITE SKETCH Scale 1:50

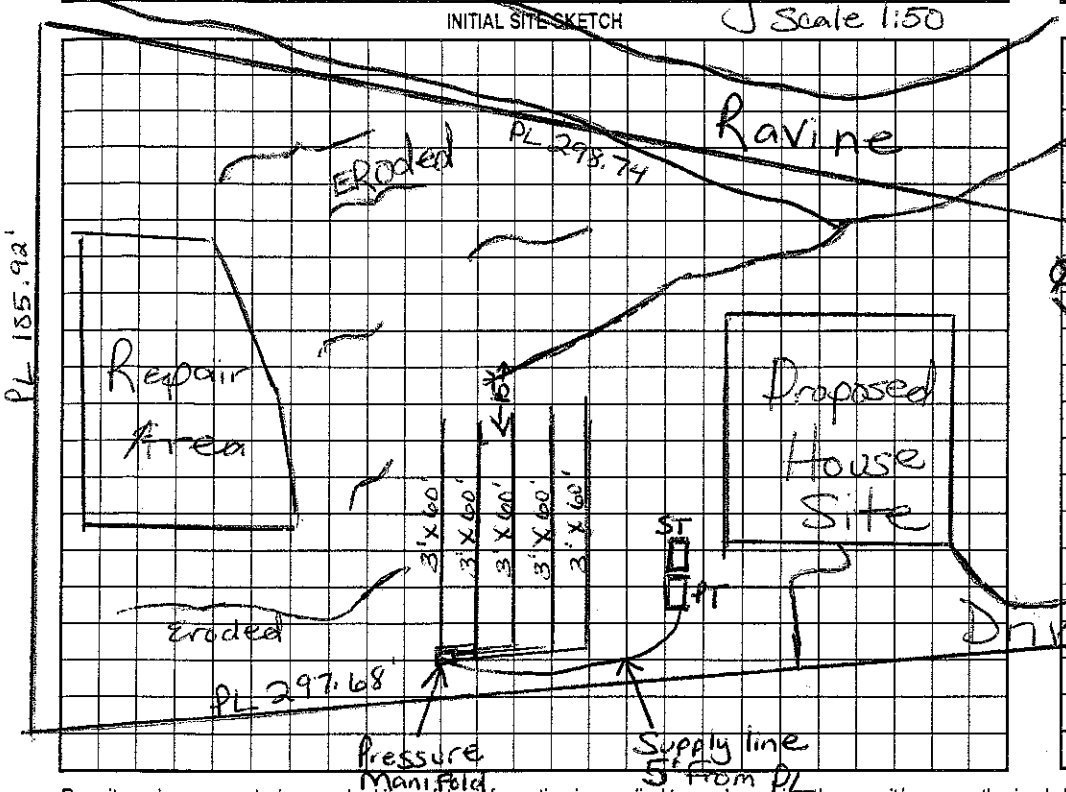

AS BUILT SKETCH

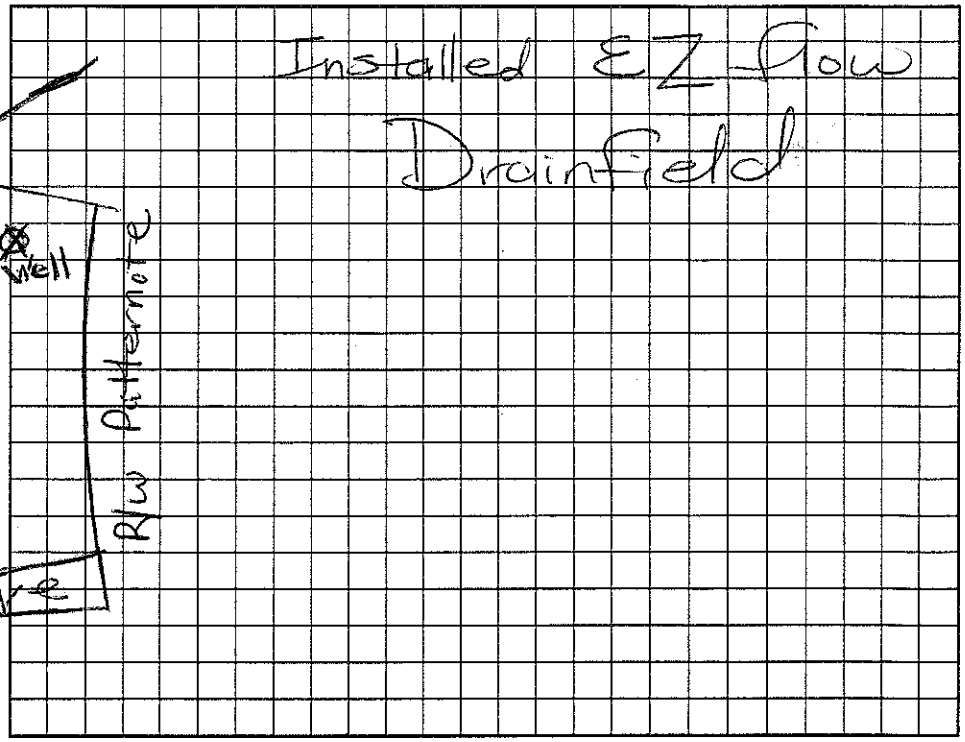

Permit can be suspended or revoked if any false information is supplied toward securing the permit/any unauthorized changes are made to the site/any unauthorized changes are made in the installation of the system. Improvement Permit with plat valid without expiration. Improvement Permit with site plan valid for sixty months. Authorization to Construct is valid for a period equal to that of Improvement Permit – not to exceed sixty months.

Signed: date 4/15/03 Installed by: Richard Abernathy

Improvement Permit by: Maria H Dotson RS date 4/15/03 Operation Permit by: RS date 7/16/03

Authorization to Construct by: Maria H Dotson RS date 4/15/03 Existing System Inspection by: date

HEALTH DEPT. COPY: WHITE OWNER COPY (FINAL): YELLOW OWNER COPY (INITIAL): PINK