2:00 – 2:30

IREDELL COUNTY HEALTH DEPARTMENT

STATESVILLE 704-878-5305 MOORESVILLE 704-664-5281

IMPROVEMENT PERMIT / AUTHORIZATION TO CONSTRUCT / OPERATION PERMIT / EXISTING SYSTEM INSPECTION

PERMIT# 07360 PIN# 4637 22 1746 4637221757 DATE 6/15/98

OWNER OR CONTRACTOR Patricia Carter JEFFREY DAVIS PHONE: Business Home 875-3393

ADDRESS 15125 Chickenroost Lane Huntersville, NC. 28078

LOCATION 1100/TR Blume TR Patternote Rd. ~1/2 mile on (L) - 177 Patternote Rd.

SUBDIVISION CL+T BLOCK / SECTION 9 LOT 1508 LOT AREA ~.94 AC SITE CLASS. PS DESIGN FLOW 360 L.T.A.R.

Septic Tank: 1000 Gallons; STB 794 Date 2/19/99
Pump Tank: 1000 Gallons; PT 274 Date 3/29/99
Pump Make: / Model / Serial No.
Nitrification Field: No Fields 1 Square Feet 720 Linear Feet 240
No Lines 3 Trench Width 2' Max Trench Bottom Depth 36" Gravel Depth SAND

☒ New System ☐ Repair System Type: I, II, III, IV, V, VI
System Description: PresMAN-16" PPBS
Repair System Description: 16" PPBS
Maintenance Agreement Required: ☐ Yes ☒ No


☒ House/Mod. Home ☐ Mobile Home ☐ Business ☐ Other
No. Bedrooms 3 No. Bathrooms 3 No. Employees
☐ Slab ☒ Crawl Space ☐ Basement w/plumbing ☒ Basement wo/plumbing

Water Supply: ☒ Individual ☐ Public ☐ Community

Comments/Conditions:

Comments/Conditions: System moved into Repair area. Repair is now above org. System

INITIAL SITE SKETCH

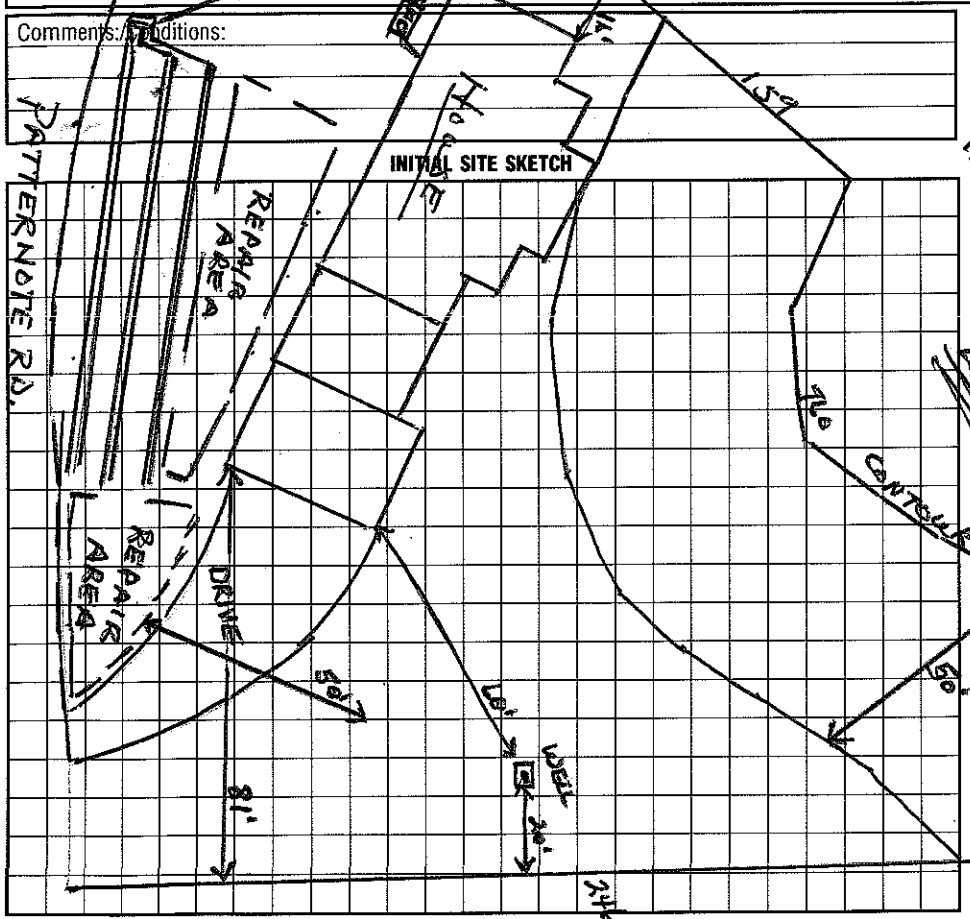

AS BUILT SKETCH

I understand that this permit can be suspended or revoked if any false information is supplied toward securing the permit/any unauthorized changes are made to the site/any unauthorized changes are made in the installation of the system. Improvement Permit with plat valid without expiration. Improvement Permit with site plan valid for sixty months. Authorization to Construct is valid for a period equal to that of Improvement Permit – not to exceed sixty months.

Signed: * [signature] date 6/16/98 Installed by: Mayhew Septic

Improvement Permit by: Wesley Sparks RS. date 6/15/98 Operation Permit by: Jeff Morgan date 4/5/99

Authorization to Construct by: Wesley Sparks RS. date 6/15/98 Existing System Inspection by: date

HEALTH DEPT. COPY: WHITE INSPECTION COPY (FINAL): GREEN OWNER COPY (FINAL): YELLOW INSPECTION COPY (INITIAL): PINK OWNER COPY (INITIAL): GOLD