COPY 12.00

IREDELL COUNTY HEALTH DEPARTMENT

STATESVILLE 704-878-5305 MOORESVILLE 704-664-5281

IMPROVEMENT PERMIT / AUTHORIZATION TO CONSTRUCT / OPERATION PERMIT / EXISTING SYSTEM INSPECTION

PERMIT# 100365 PIN# 4637-22-1460 4637223193 DATE July 9, 01

OWNER OR CONTRACTOR Blume Road Partners / Darrel Hoke PHONE: Business 704-799-7495 Home

ADDRESS 149 Yacht Cove Rd. Mooresville N.C. 28117

LOCATION Brawley Sch Rd. TR Blume TR Paternote on Right

SUBDIVISION Devonshire BLOCK / SECTION LOT 32 LOT AREA 1.08Ac SITE CLASS: PS DESIGN FLOW 480gpd L.T.A.R. .03

Septic Tank: 1000 Gallons; STB 194 Date 5/5/02
Pump Tank: 1000 Gallons; PT 27 Date 5/12/02
Pump Make: Myers Model MEJF Serial No.
Nitrification Field: No Fields 1 Square Feet 1200 Linear Feet 400
No Lines 4 Trench Width 36" Max Trench Bottom Depth 36"

☑ New System ☐ Repair System Type: I, II, (III), IV, V, VI
System Description: pm - INNOVATIVE - 25% Red.
Repair System Description: SAME
Maintenance Agreement Required: ☐ Yes ☑ No
Gravel Depth N/A ☐ Slab ☑ Crawl Space ☐ Basement w/plumbing ☐ Basement wo/plumbing


☑ House/Mod. Home ☐ Mobile Home ☐ Business ☐ Other
No. Bedrooms 4 No. Bathrooms 4 No. Employees

Water Supply: ☑ Individual ☐ Public ☐ Community


Comments:/Conditions:

Comments:/Conditions: Installed EZ Flow lines as drawn. Checked lines 1/3/2002
Checked tanks 6/14/02

INITIAL SITE SKETCH

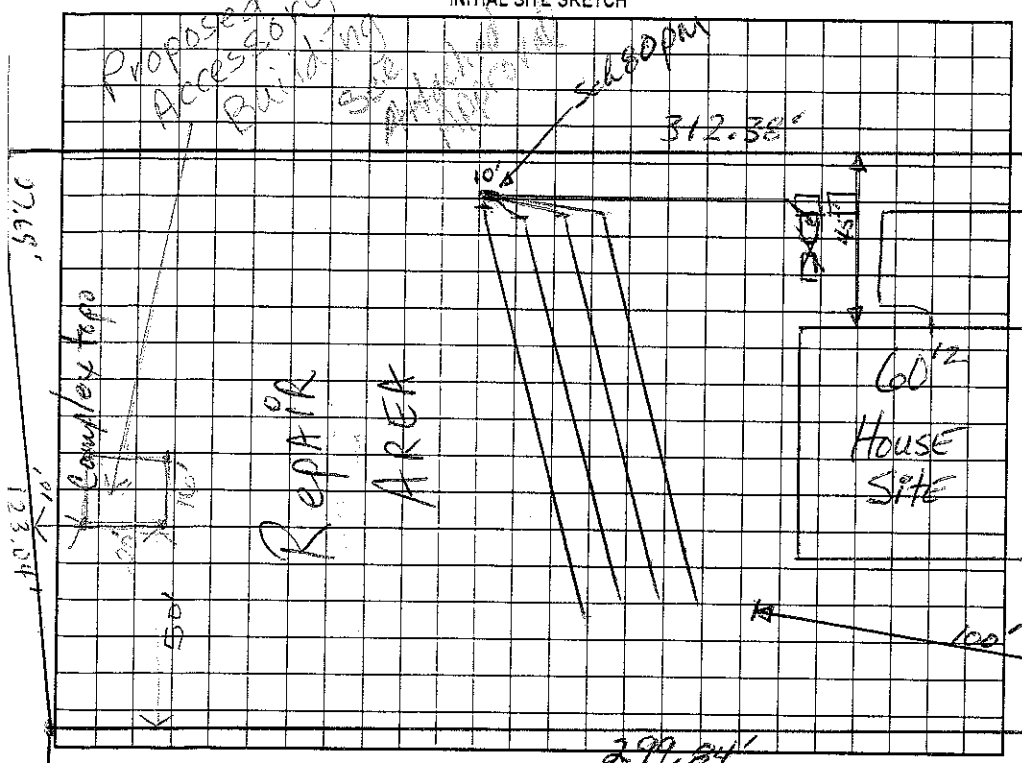

AS BUILT SKETCH

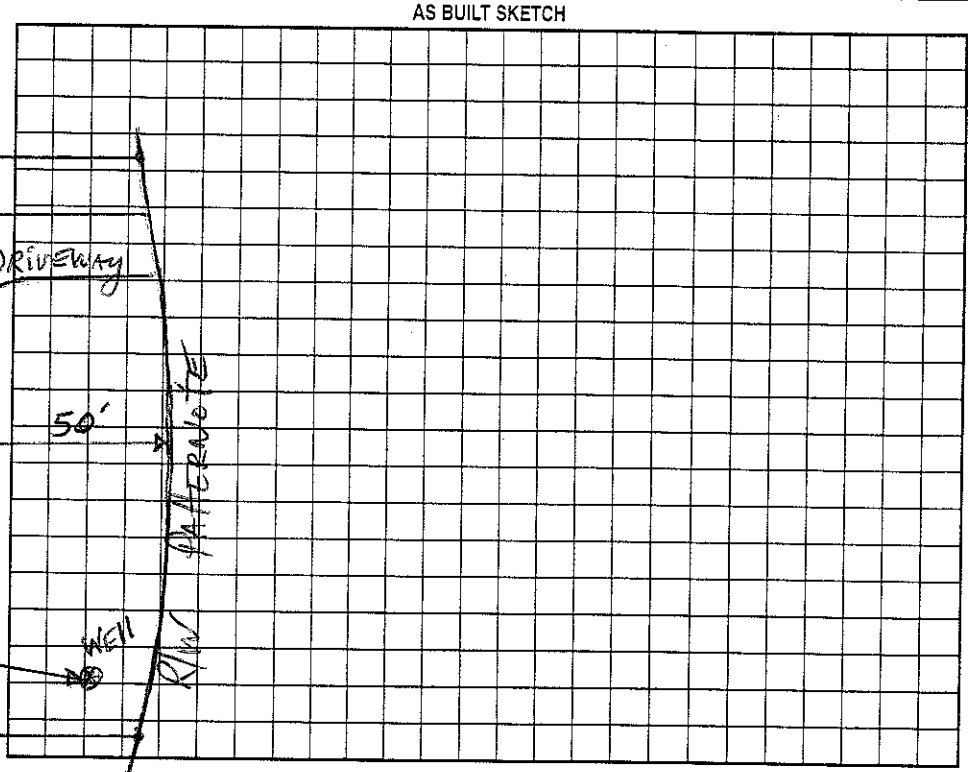

Permit can be suspended or revoked if any false information is supplied toward securing the permit/any unauthorized changes are made to the site/any unauthorized changes are made in the installation of the system. Improvement Permit with plat valid without expiration. Improvement Permit with site plan valid for sixty months. Authorization to Construct is valid for a period equal to that of Improvement Permit – not to exceed sixty months.

Signed: date 7.17.01

Improvement Permit by: RS date 7-9-01

Authorization to Construct by: RST date 12/5/01

Installed by: R & H Inc

Operation Permit by: RS date 8/23/02

Existing System Inspection by: date

HEALTH DEPT. COPY: WHITE OWNER COPY (FINAL): YELLOW OWNER COPY (INITIAL): PINK