IREDELL COUNTY HEALTH DEPARTMENT

STATESVILLE 704-878-5305 #130 MOORESVILLE 704-664-5281

IMPROVEMENT PERMIT / AUTHORIZATION TO CONSTRUCT / OPERATION PERMIT / EXISTING SYSTEM INSPECTION

PERMIT# 124647 PIN# 4637 22 34 65 ✓ DATE 11-9-04

OWNER OR CONTRACTOR TJ's Enterprises PHONE: Business _____ Home _____

ADDRESS 6000 Morris Farm Ln Charlotte NC 28227

LOCATION Brawley School Road TR Blume take to end TR Patternote on right #202

SUBDIVISION Devonshire BLOCK / SECTION _____ LOT 30 LOT AREA .83 Acre SITE CLASS PS DESIGN FLOW 360gpd L.T.A.R. 1.3

Septic Tank: 1000 Gallons; STB 794 Date 3-2-05
Pump Tank: 1000 Gallons; PT 283 Date 3-11-05
Pump Make: LittleGiant Model 9EH Serial No. _____
Nitrification Field: No Fields 1 Square Feet 900' Linear Feet 300'
No Lines 5@60 Trench Width 36" Max Trench Bottom Depth 36" Gravel Depth N/A

☒ New System ☐ Repair System Type: I, II, III, IV, V, VI
System Description: Pump - 25% Reduction
Repair System Description: Pump - Panel Block
Maintenance Agreement Required: ☐ Yes ☒ No


☒ House/Mod. Home No. Bedrooms 3
☐ Mobile Home No. Bathrooms 3.5
☐ Business No. Employees ____
☐ Other _____
☒ Slab ☐ Crawl Space ☐ Basement w/plumbing ☐ Basement wo/plumbing

Water Supply: ☒ Individual ☐ Public ☐ Community

Comments:/Conditions: Keep Septic System at least 10' From PL, 100' to well @ 15' From Cut 7 2ft.

Comments:/Conditions: Checked tanks & lines 4/18/05 MD

INITIAL SITE SKETCH Scale 1:50

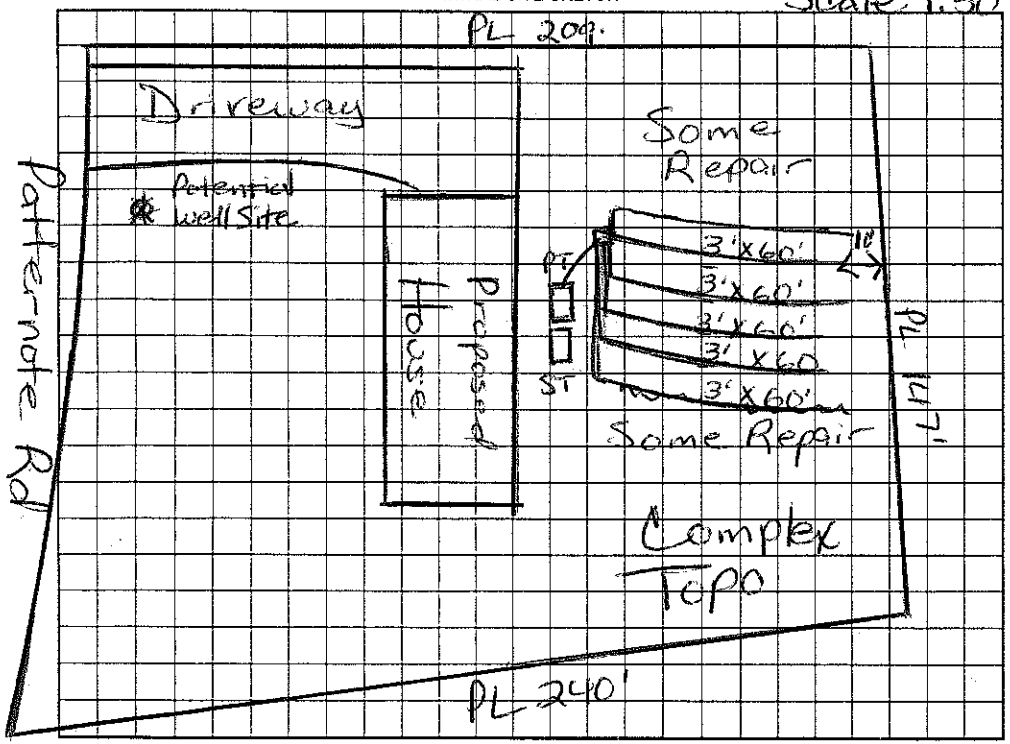

AS BUILT SKETCH

Installed "Plastic Chambers" for Drain-Field

Permit can be suspended or revoked if any false information is supplied toward securing the permit/any unauthorized changes are made to the site/any unauthorized changes are made in the installation of the system. Improvement Permit with plat valid without expiration. Improvement Permit with site plan valid for sixty months. Authorization to Construct is valid for a period equal to that of Improvement Permit – not to exceed sixty months.

Signed: TJ Hall date _____

Improvement Permit by: Maria H. Dotson RS date 11/9/04

Authorization to Construct by: Maria H. Dotson RS date 11/9/04

Installed by: Richard Freeman date 5/18/05

Operation Permit by: Maria H. Dotson RS date _____

Existing System Inspection by: _____ date _____

HEALTH DEPT. COPY: WHITE OWNER COPY (FINAL): YELLOW OWNER COPY (INITIAL): PINK