IREDELL COUNTY HEALTH DEPARTMENT

#250.00

STATESVILLE 704-878-5305 MOORESVILLE 704-664-5281

IMPROVEMENT PERMIT / AUTHORIZATION TO CONSTRUCT / OPERATION PERMIT / EXISTING SYSTEM INSPECTION

PERMIT# 137102 PIN# 4637-23-0210 DATE 8-25-06

OWNER OR APPLICANT Beau Paxton / Precision Custom Homes PHONE: Business 704-622-3425 Home

ADDRESS 19422 Meta Road Cornelius 28031

LOCATION Brawley School Rd TR Blume TR Patternote on left (149 Patternote Rd)

SUBDIVISION C L & T BLOCK / SECTION 9 LOT 156 LOT AREA .792 Ac SITE CLASS. PS DESIGN FLOW 120gpd L.T.A.R. .3 gpd/ft²

Septic Tank: Existing Gallons: STB Date

Pump Tank: Gallons: PT Date

Pump Make: Model Serial No.

Nitrification Field: No Fields 1 Square Feet Linear Feet 100'

No Lines 2@50' Trench Width 24" Max Trench Bottom Depth 36" Gravel Depth NA ☒ Gravity ☐ Pressure

☐ New System ☐ Repair ☒ Expansion System Type: I II (III) IV V VI

System Description: PPBPS Gravity

Repair System Description: PPBPS pump

Maintenance Agreement Required: ☐ Yes ☒ No

☒ House/Mod. Home No. Bedrooms 3

☐ Mobile Home No. Persons

☐ Business No. Employees

☐ Other

Water Supply: ☒ Individual ☐ Public ☐ Community

☐ Slab ☒ Crawl Space ☐ Basement w/plumbing ☐ Basement wo/plumbing

Comments:/Conditions:

① 2 Bedroom Existing house expanding to 3 Bd.


② Building foundation including deck posts shall be min. 5 ft. from tank or drain lines

③ Space trenches to allow for 6 ft. natural soil between trenches


④ T for 3 lines in Existing system

Comments:/Conditions:

INITIAL SITE SKETCH

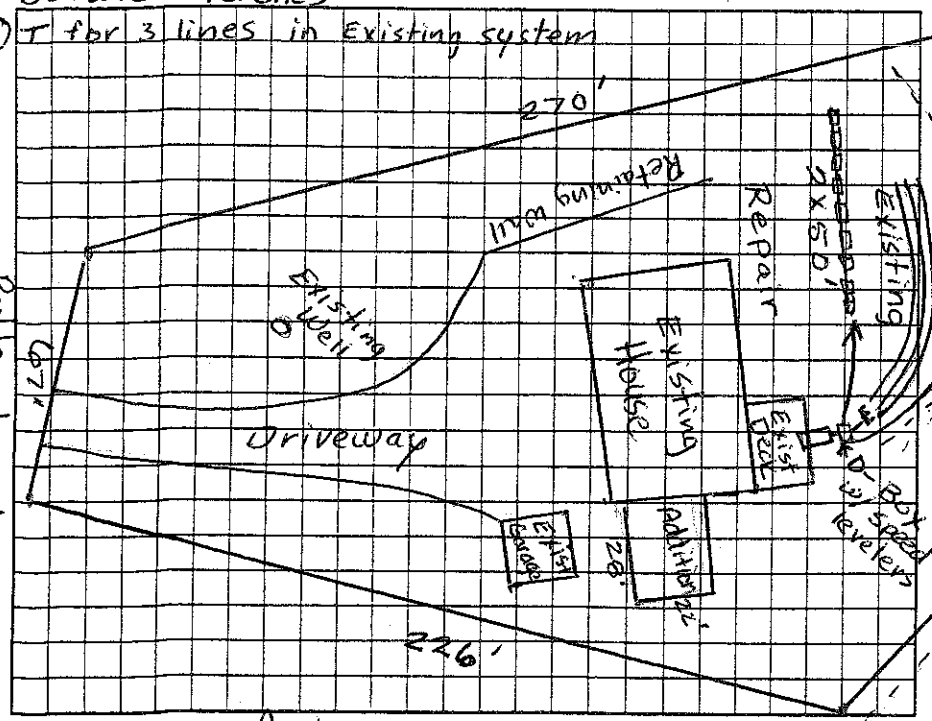

AS BUILT SKETCH

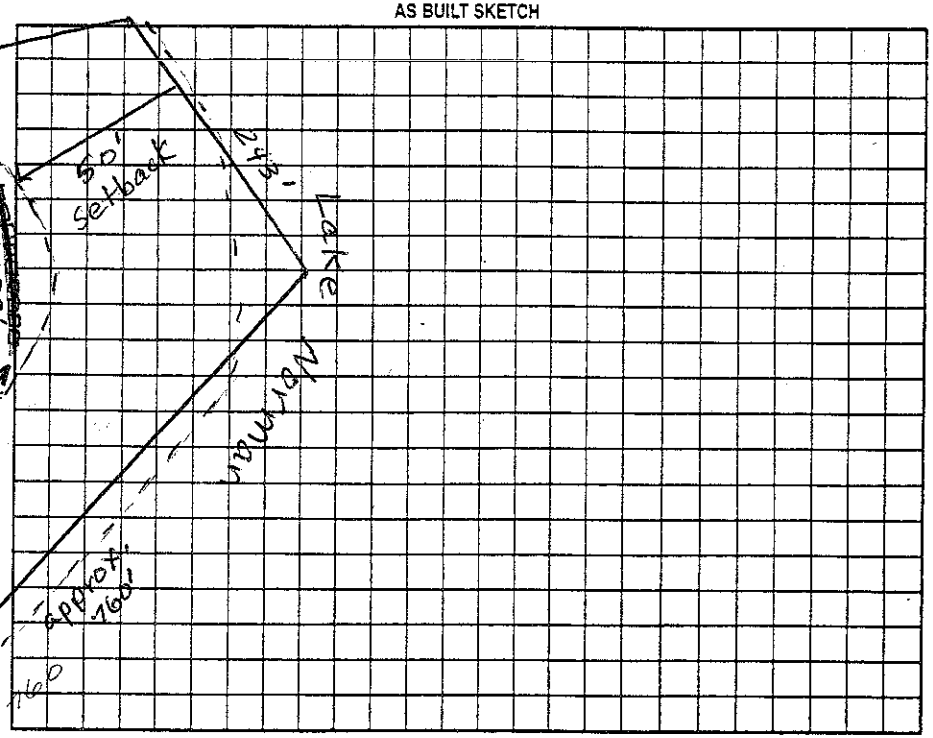

Permit can be suspended or revoked if any false information is supplied toward securing the permit/any unauthorized changes are made to the site/any unauthorized changes are made in the installation of the system. Improvement Permit with plan valid without expiration. ☐ Improvement Permit with site plan valid for sixty months ☒ Authorization to Construct is valid for a period equal to that of Improvement Permit – not to exceed sixty months.

Signed: Dean Hyl date 9-12-06 Installed by: Brad Johnson

Improvement Permit by: Judy Melville date 8-29-06 Operation Permit by: Jph & Agt date 2/2/07

Authorization to Construct by: Judy Melville date 9-12-06 Existing System Inspection by: date

HEALTH DEPT. COPY: WHITE OWNER COPY (FINAL): YELLOW OWNER COPY (INITIAL): PINK