2430

IREDELL COUNTY HEALTH DEPARTMENT

STATESVILLE 704-878-5305 MOORESVILLE 704-664-5281

IMPROVEMENT PERMIT / AUTHORIZATION TO CONSTRUCT / OPERATION PERMIT / EXISTING SYSTEM INSPECTION

PERMIT# 146294 PIN# 4637251453.014 4637-24-0933 DATE 11-27-07

OWNER OR APPLICANT Lakeland Luxury PHONE: Business 704-892-1878 Home

ADDRESS 16405-D Northcross Dr Huntersville NC 28078

LOCATION Hwy 150 W TL McCrary TL Riverwood on left

SUBDIVISION Riverwood Bend BLOCK / SECTION LOT 14 LOT AREA .69 AC SITE CLASS. PS DESIGN FLOW 480gpd L.T.A.R.

Septic Tank: 1000 Gallons: STB 825 Date 6-25-08
Pump Tank: 1000 Gallons: PT 302 Date 3-11-08
Pump Make: Zoeller 4HP Model N152-B Serial No.
Nitrification Field: No Fields 1 Square Feet 1200 Linear Feet 400
No Lines 4@100' Trench Width 36" Max Trench Bottom Depth 36"

☒ New System ☐ Repair ☐ Expansion System Type: I II III IV V VI
System Description: 25% reduction ~~gravity~~
Repair System Description: 2P PPBPS Pump
Maintenance Agreement Required: ☐ Yes ☒ No

☒ House/Mod. Home ☐ Mobile Home ☐ Business ☐ Other
No. Bedrooms 4 No. Persons 8 No. Employees

Water Supply: ☒ Individual ☐ Public ☐ Community

Gravel Depth N/A ☒ Gravity ☐ Pressure ☐ Slab ☒ Crawl Space ☐ Basement w/plumbing ☐ Basement wo/plumbing

Comments:/Conditions:

Comments:/Conditions: Plans reviewed essentially same as I.P.
2/21/08 AC.

INITIAL SITE SKETCH

See Plan from SAME

AS BUILT SKETCH

7/30/08 Lines, Tanks & pressure checked AC.
Infiltrator Quick 4 Installed
11/5/08 Electrical & Alarm A.S.

Permit can be suspended or revoked if any false information is supplied toward securing the permit/any unauthorized changes are made to the site/any unauthorized changes are made in the installation of the system. Improvement Permit with plat valid without expiration ☐ Improvement Permit with site plan valid for sixty months ☒ Authorization to Construct is valid for a period equal to that of Improvement Permit – not to exceed sixty months.

Signed: _____ date 12/6/07

Improvement Permit by: Judy Melville date 11-27-07


Authorization to Construct by: Anthony Coker P.E. date 2/21/08

Installed by: Rowan Septic

Operation Permit by: Anthony Coker P.E. date 11/5/08

Existing System Inspection by: _____ date _____

HEALTH DEPT. COPY: WHITE OWNER COPY (FINAL): YELLOW OWNER COPY (INITIAL): PINK

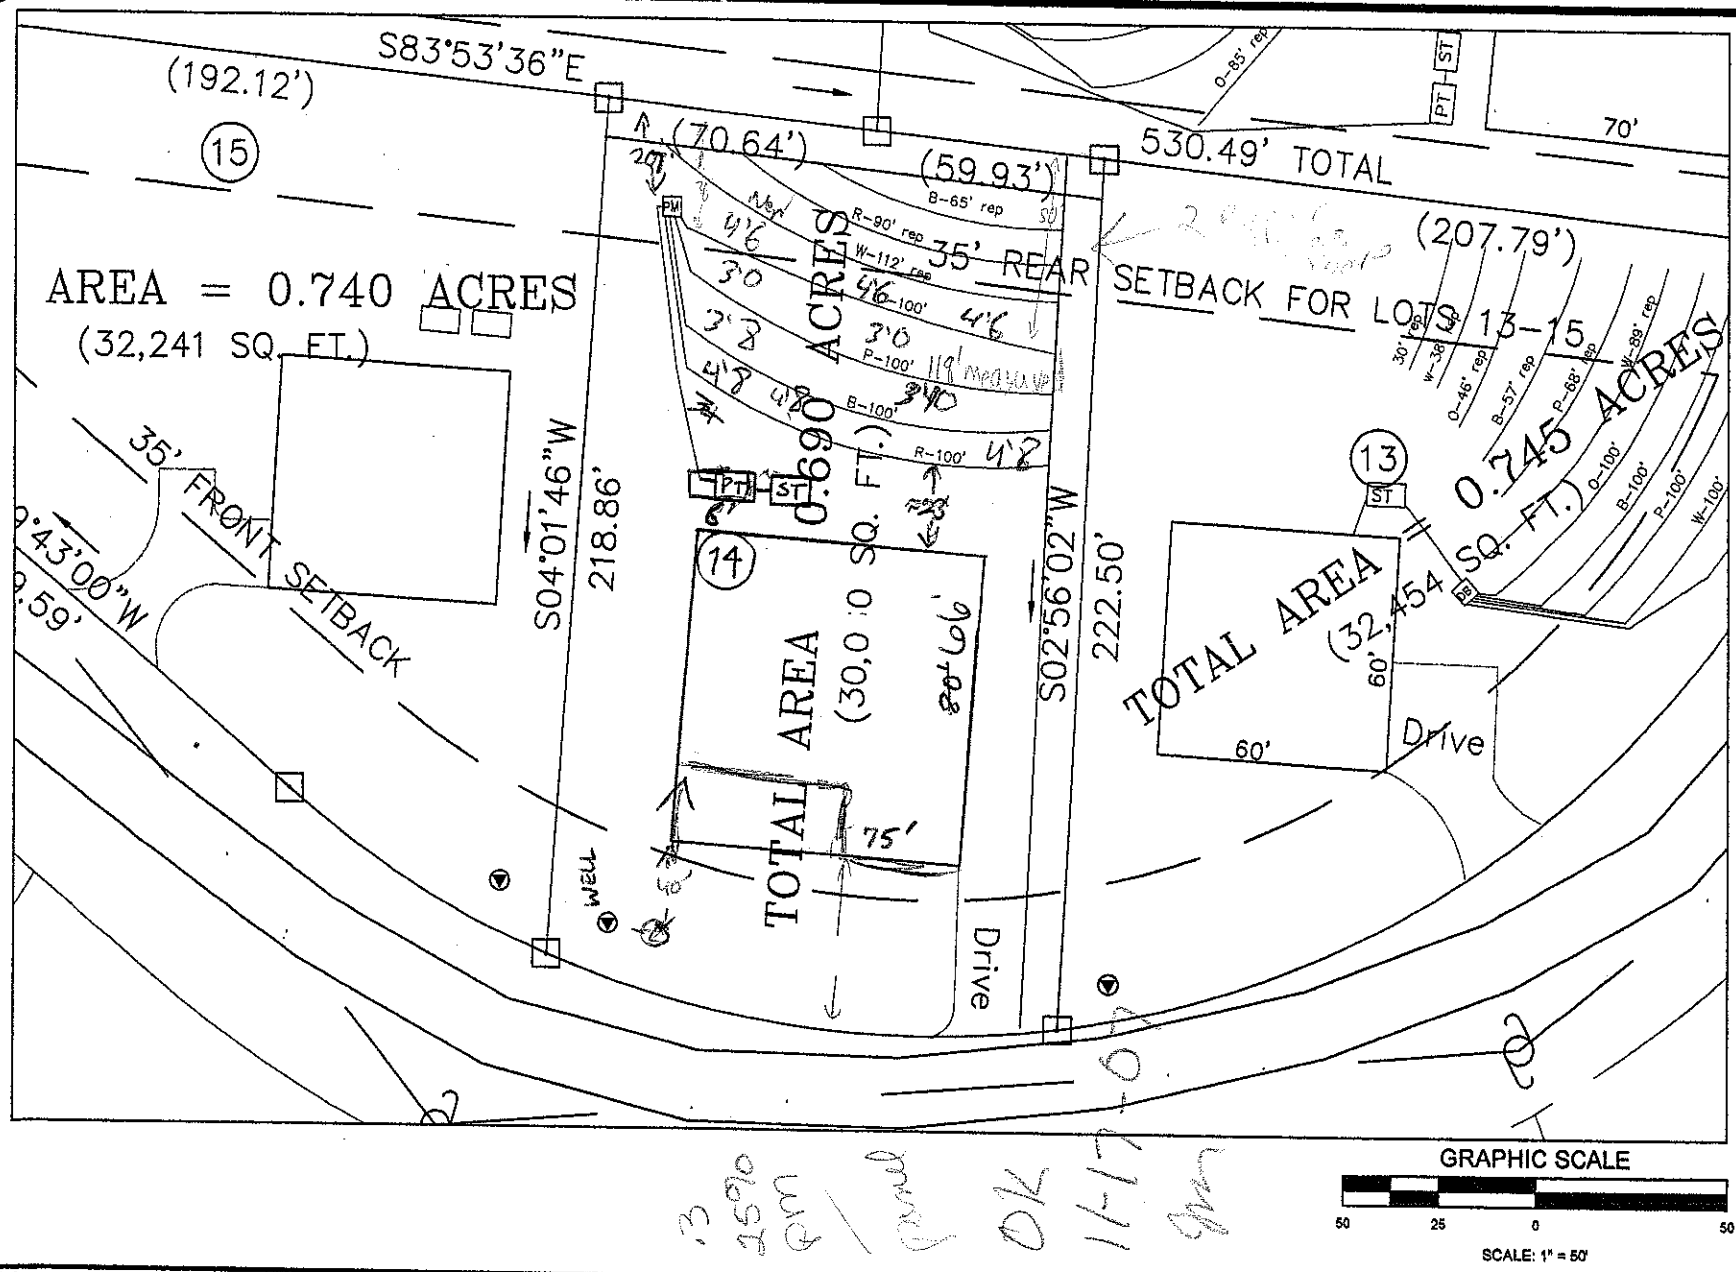

SCALE: 1" = 50'	DATE: 11-7-07	S&ME	3718 OLD BATTLEGROUND ROAD GREENSBORO, NC 27410 PH. 336-288-7180 FAX. 336-288-8980 WWW.SMEINC.COM	Lot 14 Riverwood Bend Subdivision – McCrary Rd. Iredell County, NC	FIGURE NO. 1
PROJECT NO. 1588-07-051	DRAWN BY: JBP				
	CHECKED BY: PLM				