IREDELL COUNTY HEALTH DEPARTMENT

Statesville Office (704) 878-5305 Mooresville Office (704) 660-3625 PERMIT # 205736 / 205972

IMPROVEMENT PERMIT / AUTHORIZATION TO CONSTRUCT / OPERATION PERMIT / EXISTING SYSTEM

PIN # 4637-25-0502

APPLICANT: MARK MORGAN APPLICANT ADDRESS:

SITE ADDRESS: 142 RIVERWOOD RD. PHONE: 704-582-3818 ALT. PHONE:

SITE DIRECTIONS: 150 W. MCCRARY, RIVERWOOD, ON (L)

SUBDIVISION: RIVERWOOD BEND SECTION: LOT # 8 LOT AREA: .732 AC DESIGN FLOW: 360 L.T.A.R.: .3

Septic Tank 1000 (gal) STB 1012 Date 9-2-14
Pump Tank 1000 (gal) PT 17 Date 6-21-14
Pump Make GOULDS Model WE03J2MU Serial #
Nitrification Fields 1 # Lines 4 Linear Ft: 300'
Trench Width 36" Max. Trench Bottom Depth 24" Gravel Depth

☒ New System ☐ Repair ☐ Expansion System Type: I II (III) IV V VI
System Description: PM 25% REDUCTION
Repair System Description: PANEL BLOCK
Maintenance Agreement Required: ☐ YES ☒ NO
☐ GRAVITY ☒ PRESSURE

☒ Residence ☐ Business ☐ Other ☐ Slab ☐ Basement w/plumbing
No. Bedrooms 3 No. Persons 6 No. Employees ☒ Crawl Space ☐ Basement w/o plumbing

Water Supply: ☒ Private ☐ Public ☐ Community

Comments / Conditions:

INITIAL SITE SKETCH

SEE ATTACHED PLAN FROM KATHLEEN SAUNDERS

RA APPROVED OCT 28 2014

AS BUILT SKETCH

CHECKED LINES & TANKS RA 5-1-15

SET 2'PM, CHECKED ELECTRICAL & ALARM 5-13-15

Permit can be suspended or revoked if any false information is supplied toward securing the permit / any unauthorized changes are made to the site / any unauthorized changes are made in the installation of the system. **CONTACT A LOCATOR SERVICE PRIOR TO ANY EXCAVATION**

☐ **IMPROVEMENT PERMIT** *with plat valid without expiration.* ☒ **IMPROVEMENT PERMIT** *with site plan valid for 60 mos.* ☒ **AUTHORIZATION TO CONSTRUCT** *valid for period equal to IMPROVEMENT PERMIT--not to exceed 60 mo.*

Owner / Applicant Signature: Kathleen Saunders Date:

IMPROVEMENT PERMIT by: RA APPROVED Date: OCT 28 2014


AUTHORIZATION TO CONSTRUCT by: RA APPROVED Date: OCT 28 2014

Installed by: CRAIG THOMPSON

OPERATION PERMIT by: RA Date: 5-13-15

Existing System Inspected by: Date:

Health Dept. Copy - WHITE Applicant (Final Approval) - YELLOW Applicant (Conditional Approval) - PINK

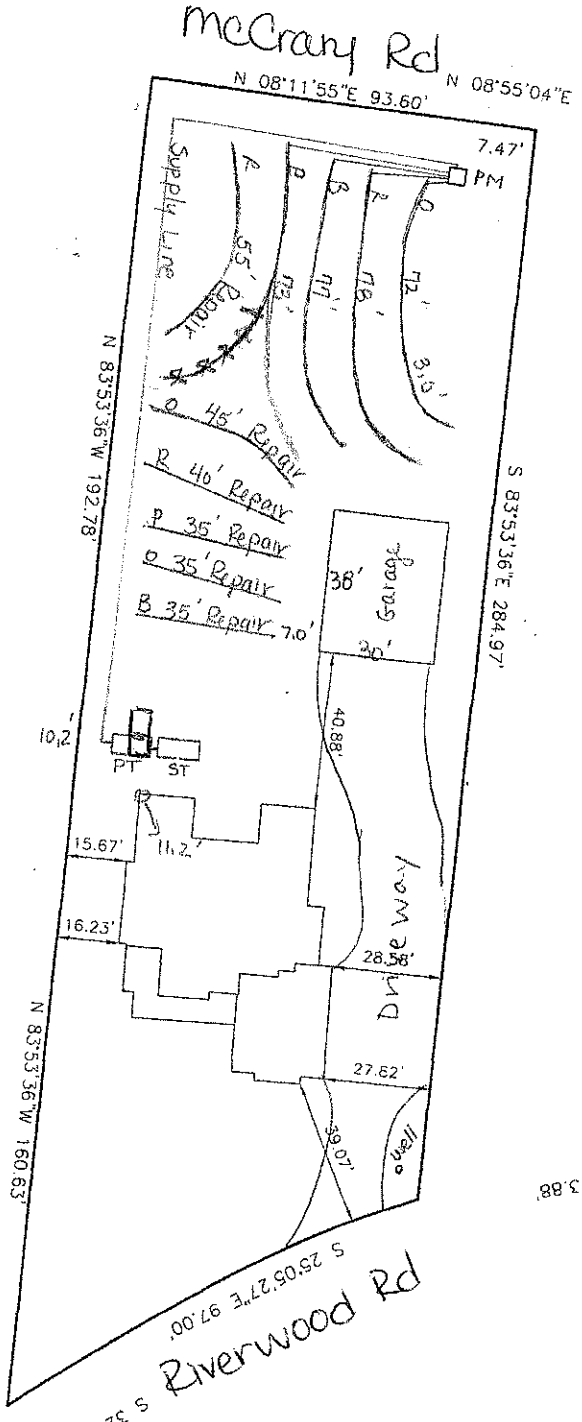

OK
ICHD

10/27/14

1" = 50'