IREDELL COUNTY HEALTH DEPARTMENT

STATESVILLE 704-878-5305 MOORESVILLE 704-664-5281

IMPROVEMENT PERMIT / AUTHORIZATION TO CONSTRUCT / OPERATION PERMIT / EXISTING SYSTEM INSPECTION

PERMIT # 164588 & 164589 PIN # 4637250621 DATE 1-24-2011

OWNER or APPLICANT LWA Contracting Inc / Robert Area PHONE: Business 704 361-1085 Home:

OWNER or APPLICANT ADDRESS 127 B Promenade Dr Mooresville NC 28117

LOCATION / DIRECTIONS Hwy 150 W. TL McCrary TL Riverwood on left

SUBDIVISION Riverwood Bend BLOCK / SECTION LOT # 1 LOT AREA .66 Ac DESIGN FLOW 480 gpd L.T.A.R. 3

Septic Tank 1000 Gallons: STB Date

Pump Tank 1000 Gallons: PT Date

Pump Make Model Serial #

Nitrification Field No Fields 1 No Lines 3 Linear Feet 286'

Trench Width 24" Max. Trench Bottom Depth 36" Gravel Depth N/A

☐ New System ☐ Repair ☐ Expansion System Type I II III IV V VI

System Description: Existing Pump-LP-Panel Blk

Repair System Description: Same

Maintenance Agreement Required ☒ YES ☐ NO

☐ GRAVITY ☒ PRESSURE

☒ Residence No. Bedrooms 4 Water Supply

☐ Business No. Persons ☒ Private

☐ Other No. Employees ☐ Public


☐ Slab ☐ Crawl Space ☐ Community

☐ Basement w/plumbing ☐ Basement w/o plumbing


Comments / Conditions: Existing Septic appears to be functioning okay at time of inspection. Must keep current on Maint. Contract with Cert. Operator

Comments / Conditions: Any Bldg. must be at least 5ft from Septic System. (Including Repair Areas)

INITIAL SITE SKETCH

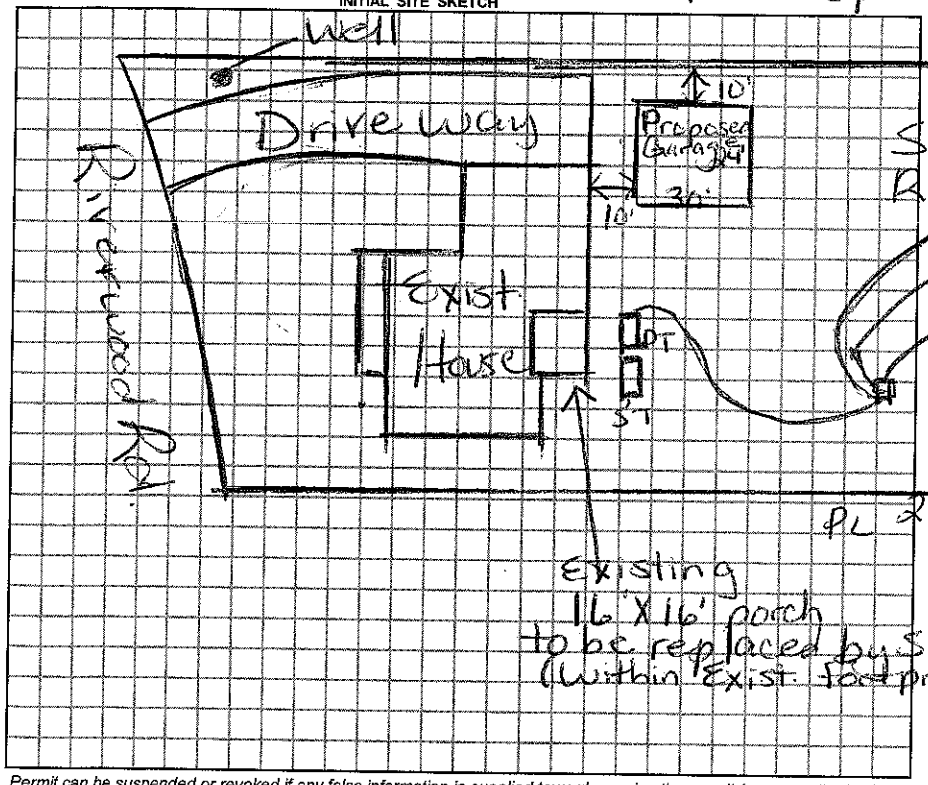

AS BUILT SKETCH

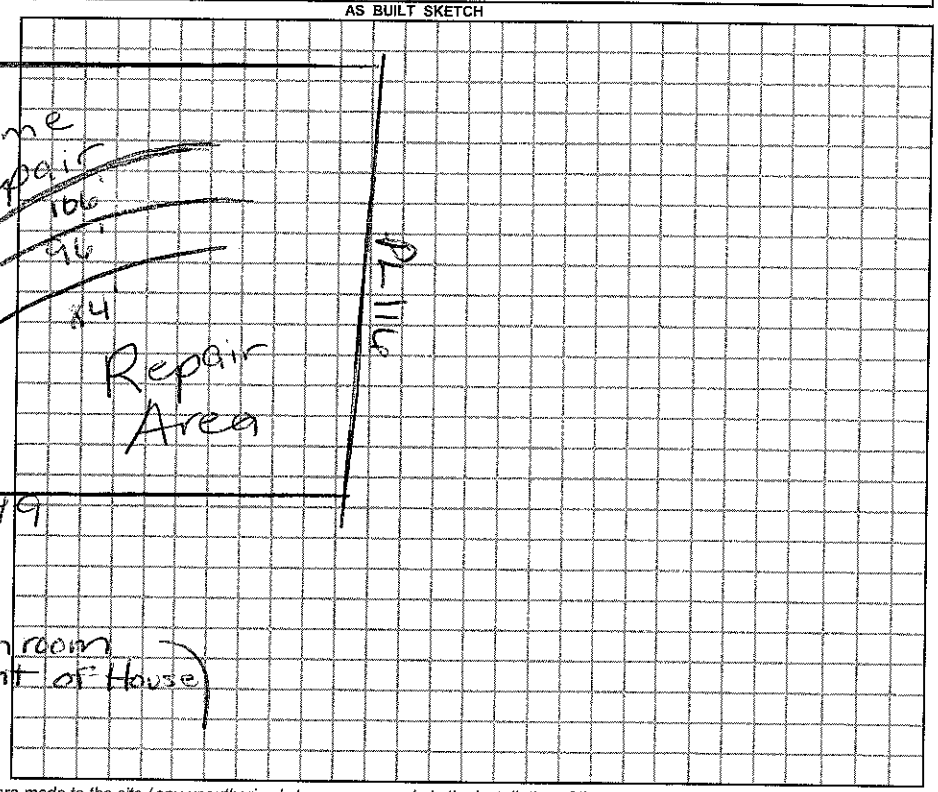

Permit can be suspended or revoked if any false information is supplied toward securing the permit / any unauthorized changes are made to the site / any unauthorized changes are made in the installation of the system.

☐ *IMPROVEMENT PERMIT w / plat valid without expiration* ☐ *IMPROVEMENT PERMIT w / site plan valid for 60 mos.* ☐ *AUTHORIZATION TO CONSTRUCT valid for period equal to IMPROVEMENT PERMIT-not to exceed 60 mo.*

Owner / Applicant Signature: X [signature] Date 2/2/11

Improvement Permit by: Date

Authorization to Construct by: Date

YOU SHOULD CONTACT A LOCATOR SERVICE PRIOR TO ANY EXCAVATION.

Installed by: Rowan Septic 5/23/08

Operation Permit by: Date:

Existing System Inspected by: [signature] Date: 1/24/2011

WHITE COPY Environmental Health YELLOW COPY (Final) Owner / Applicant PINK COPY (Initial) Owner / Applicant