IREDELL COUNTY HEALTH DEPARTMENT

Statesville Office (704) 878-5305 Mooresville Office (704) 660-3625 PERMIT # 1486266

IMPROVEMENT PERMIT / AUTHORIZATION TO CONSTRUCT / OPERATION PERMIT / EXISTING SYSTEM

PIN # 4937250817

APPLICANT: Tim Furr APPLICANT ADDRESS: 8410 Pit Stop Ct Suite 122

SITE ADDRESS: 128 Riverwood Rd PHONE: 704-787-0489 ALT. PHONE:

SITE DIRECTIONS: 150 W, TL McCrary, TL @ End, on L

SUBDIVISION: Riverwood Bend SECTION: LOT # 5 LOT AREA: .689 AC DESIGN FLOW: 360 L.T.A.R.: .13

Septic Tank 1000 (gal) STB 794 Date 6-1-13

Pump Tank 1000 (gal) PT 283 Date 3-4-13

Pump Make Model Serial #

Nitrification Fields 1 # Lines 3 Linear Ft: 200'

Trench Width 24" Max. Trench Bottom Depth 36" Gravel Depth

☒ New System ☐ Repair ☐ Expansion System Type: I II III ☒ IV V VI

System Description: LP- Panel Block

Repair System Description: Same

Maintenance Agreement Required: ☒ YES ☐ NO

☐ GRAVITY ☒ PRESSURE

☒ Residence ☐ Business ☐ Other ☐ Slab ☐ Basement w/plumbing

No. Bedrooms 3 No. Persons No. Employees


☒ Crawl Space

Water Supply: ☒ Private ☐ Public ☐ Community

☐ Basement w/o plumbing


Comments / Conditions:

INITIAL SITE SKETCH

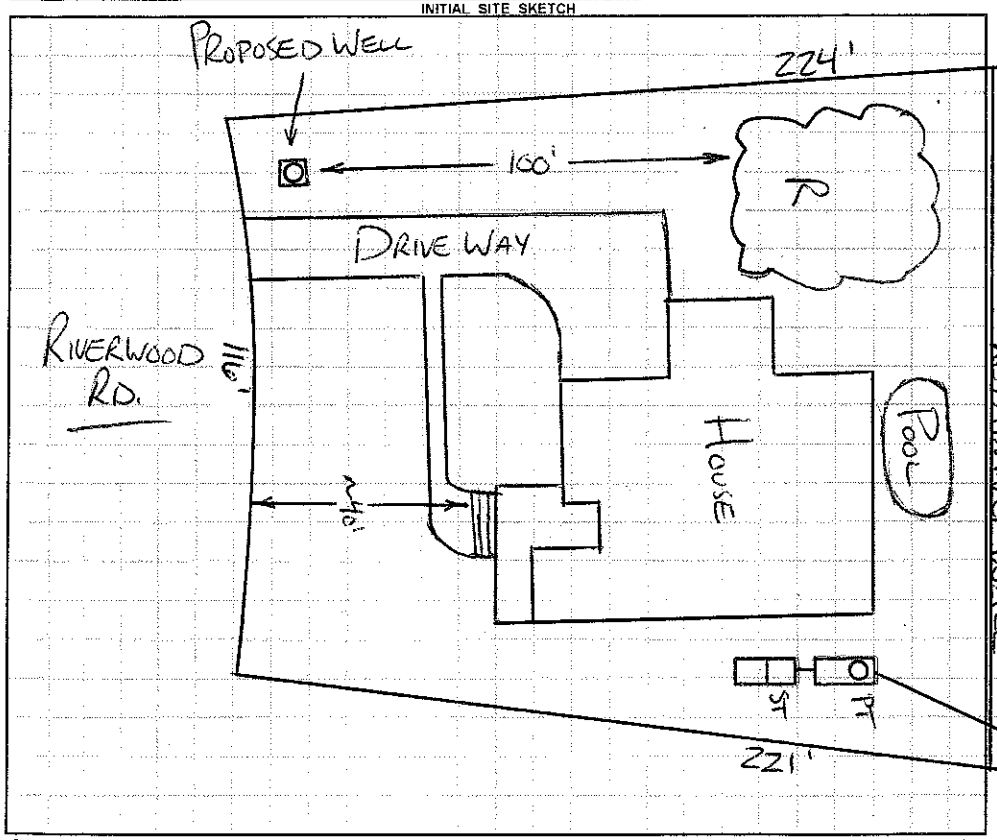

AS BUILT SKETCH

1"=40

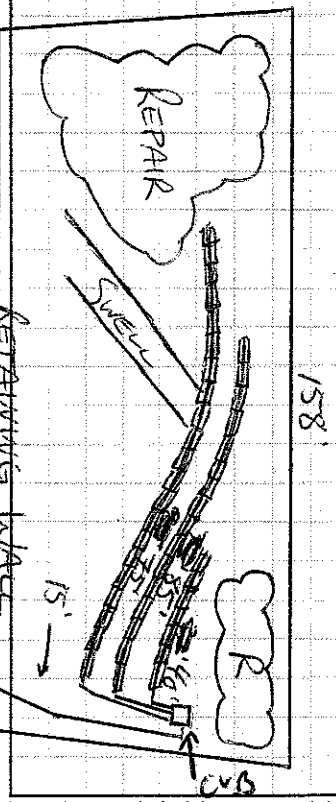

Checked Lines & Tanks 7-25-13

Set 2½' PH 10-24-13

Permit can be suspended or revoked if any false information is supplied toward securing the permit / any unauthorized changes are made to the site / any unauthorized changes are made in the installation of the system. **CONTACT A LOCATOR SERVICE PRIOR TO ANY EXCAVATION**

☐ **IMPROVEMENT PERMIT** *with plat valid without expiration.* ☒ **IMPROVEMENT PERMIT** *with site plan valid for 60 mos.* ☒ **AUTHORIZATION TO CONSTRUCT** *valid for period equal to IMPROVEMENT PERMIT--not to exceed 60 mo.*

Owner / Applicant Signature: Date: 4-17-13 Installed by: Waste Water Solutions

IMPROVEMENT PERMIT by: Date: 4-16-13 OPERATION PERMIT by: Date: 10-24-13

AUTHORIZATION TO CONSTRUCT by: Date: 4/25/13 Existing System Inspected by: Date:

Health Dept. Copy - WHITE Applicant (Final Approval) - YELLOW Applicant (Conditional Approval) - PINK