IREDELL COUNTY HEALTH DEPARTMENT

Statesville Office (704) 878-5305 Mooresville Office (704) 660-3625 PERMIT # 179378

IMPROVEMENT PERMIT / AUTHORIZATION TO CONSTRUCT / OPERATION PERMIT / EXISTING SYSTEM

PIN # 4637-25-1176 1592

APPLICANT: R. MORGAN HOMES APPLICANT ADDRESS: PO BOX 375 HUNTERSVILLE 28070

SITE ADDRESS: RIVERWOOD PHONE: 704-582-3818 ALT. PHONE:

SITE DIRECTIONS: 150 W, TL MCCRARY, TL RIVERWOOD, ON L


SUBDIVISION: RIVERWOOD REND SECTION: LOT # 10 LOT AREA: 1.234 AC DESIGN FLOW: 480 L.T.A.R.: 3

Septic Tank	1000 (gal)	STB	1012	Date	1-11	☒ New System	☐ Repair	☐ Expansion	System Type: I II (III)B IV V VI	☒ Residence	No. Bedrooms 4
Pump Tank	1000 (gal)	PT	17	Date	5-12-10	System Description:	PM - 25% REDUCTION			☐ Business	No. Persons
Pump Make	GOULDS	Model	WE05H	Serial #		Repair System Description:	SAME			☐ Other	No. Employees
# Nitrification Fields	1	# Lines	4C100'	Linear Ft:	400'	Maintenance Agreement Required:	☐ YES	☒ NO		☐ Slab	☒ Crawl Space
Trench Width	36"	Max. Trench Bottom Depth	*30"*	Gravel Depth			☐ GRAVITY	☒ PRESSURE		☐ Basement w/plumbing	☐ Basement w/o plumbing


Water Supply: ☒ Private ☐ Public ☐ Community

Comments / Conditions: 6/19/13 Reviewed Floor plans 3 Bedrooms initially, baths' Septic Sized for 4 Bedrooms

INITIAL SITE SKETCH

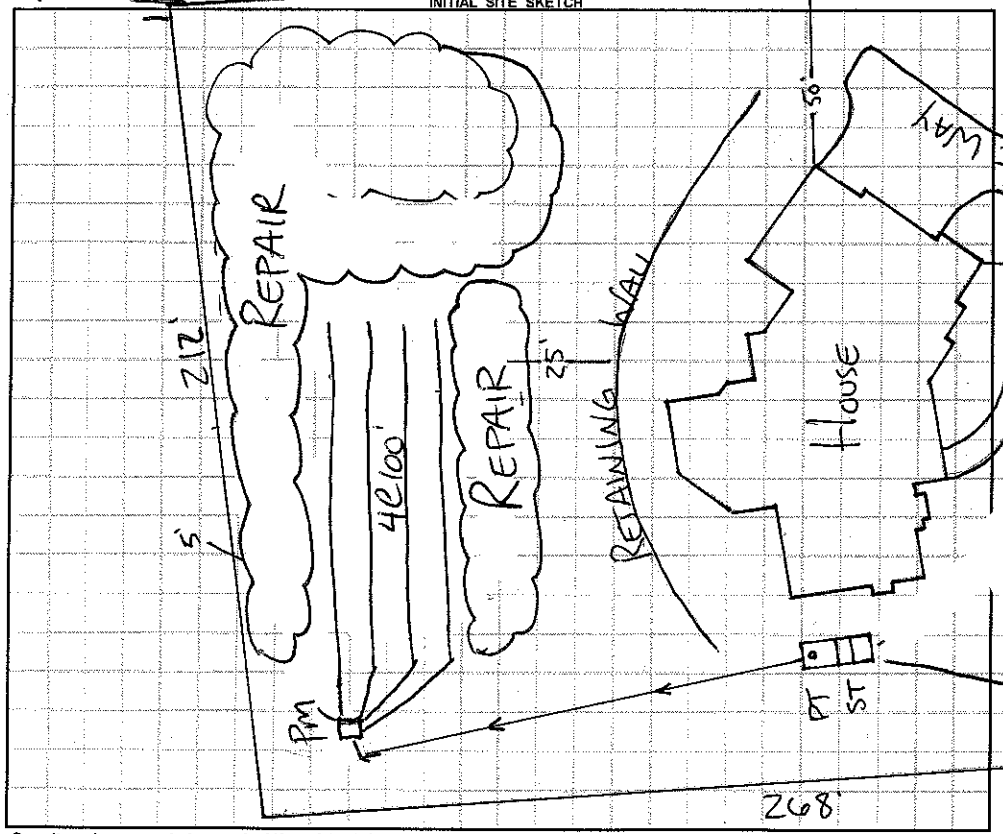

AS BUILT SKETCH

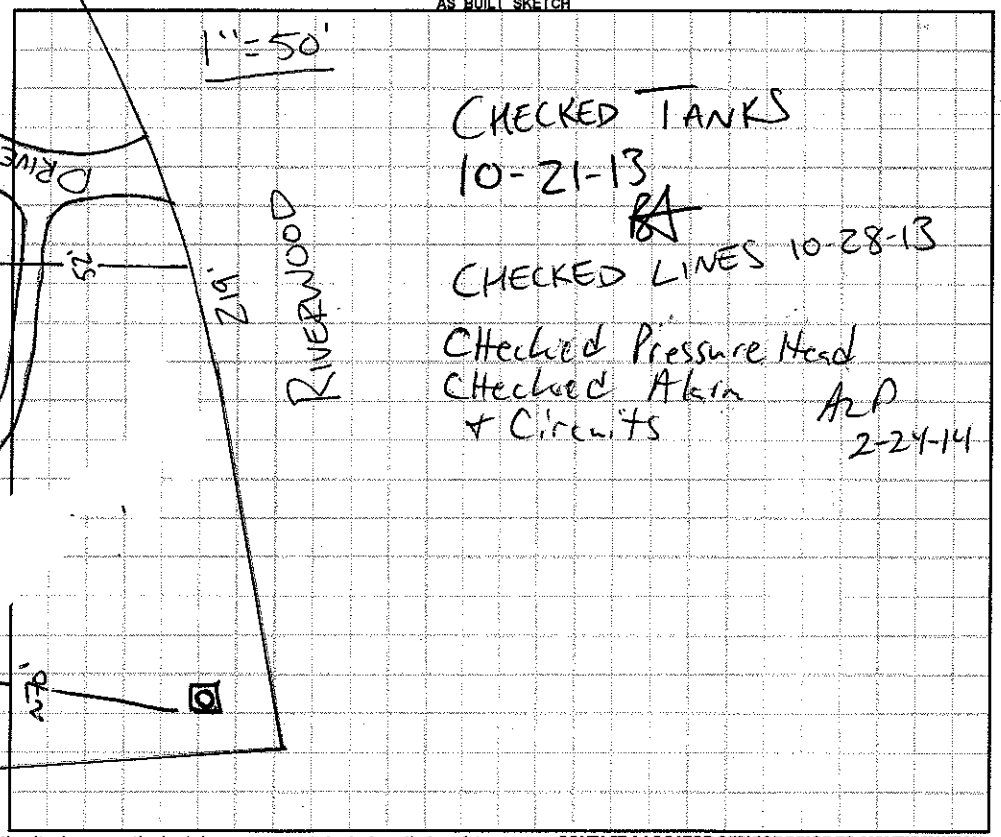

CHECKED TANKS 10-21-13 BA

CHECKED LINES 10-28-13

CHecked Pressure Head CHecked Alrm + Circuits AP 2-24-14

Permit can be suspended or revoked if any false information is supplied toward securing the permit / any unauthorized changes are made to the site / any unauthorized changes are made in the installation of the system. **CONTACT A LOCATOR SERVICE PRIOR TO ANY EXCAVATION**

☐ **IMPROVEMENT PERMIT** ***with plat*** *valid without expiration.* ☒ **IMPROVEMENT PERMIT** ***with site plan*** *valid for 60 mos.* ☐ **AUTHORIZATION TO CONSTRUCT** *valid for period equal to IMPROVEMENT PERMIT--not to exceed 60 mo.*

Owner / Applicant Signature: Date: Installed by: Tommy FRY

IMPROVEMENT PERMIT by: BA Date: 6-17-13 OPERATION PERMIT by: Date: 2-24-14

AUTHORIZATION TO CONSTRUCT by: Date: 6/19/13 Existing System Inspected by: Date:

Health Dept. Copy - WHITE Applicant (Final Approval) - YELLOW Applicant (Conditional Approval) - PINK