2nd

IREDELL COUNTY HEALTH DEPARTMENT

STATESVILLE 704-878-5305 MOORESVILLE 704-664-5281

IMPROVEMENT PERMIT / CERTIFICATE OF COMPLETION / OPERATION PERMIT / EXISTING SYSTEM INSPECTION

PROPERTY DESCRIPTION NO. 21454 DATE 8/25/95 TAX MAP NO. 2P-3-A-54 4637254087 Watershed: [X] Yes [ ] No

OWNER OR CONTRACTOR Eric Frye PHONE: Business _____ Home 664-0822

ADDRESS 151 Cherokee Dr. Mooresville NC. 28115

LOCATION McCrary Rd TL Riverwood Rd. to 5th lot on (R)

SUBDIVISION CL+T BLOCK / SECTION 10 LOT 54 LOT AREA .75 AC SITE CLASS PS DESIGN FLOW 360 L.T.A.R. .3

Septic Tank: 1000 Gallons; STB 794 Date 4/18/97
Pump Tank: 1000 Gallons; PT 27 Date 5/20/97
Pump Make: HYDROMATIC Model _____ Serial No. _____
Nitrification Field: No Fields 1 Square Feet 1200 Linear Feet 300
No Lines 300 Trench Width 36" Max Trench Bottom Depth 36" Gravel Depth N/A

[X] New System [ ] Repair System Type: I, II, (III) IV, V, VI
System Description: Pres Mcyfield - INFILTRATOR
Repair System Description: _____
Maintenance Agreement Required: [X] Yes [ ] No


[X] House/Mod. Home No. Bedrooms 3
[ ] Mobile Home No. Bathrooms 2
[ ] Business No. Employees _____
[ ] Other _____
[ ] Slab [X] Crawl Space [X] Basement w/plumbing [ ] Basement wo/plumbing

Water Supply: [X] Individual [ ] Community [ ] Public

Comments: Old well must be abandoned before new system may be installed.

Comments:

INITIAL SITE SKETCH

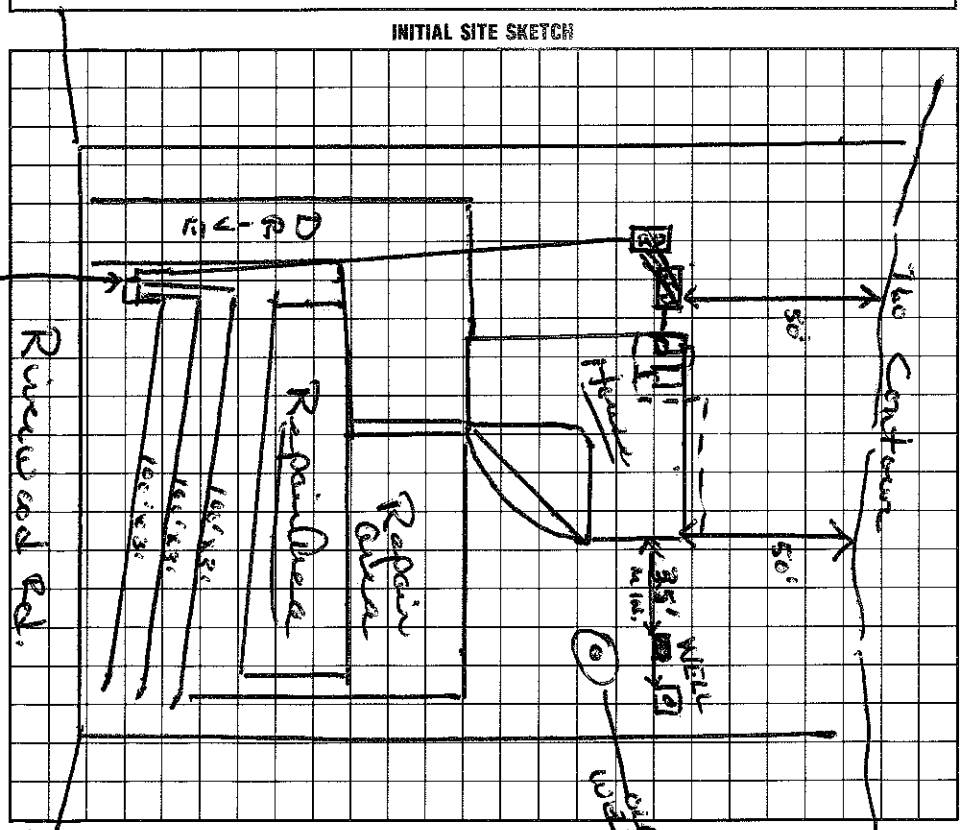

AS BUILT SKETCH

I understand that this permit can be suspended or revoked if any false information is supplied toward securing the permit/any unauthorized changes are made to the site/any unauthorized changes are made in the installation of the system.

Signed: Eric L. Frye

Improvement Permit by: Wesley Sparks date 8/25/95

Existing System Inspection by: _____ date _____

Installed by: Tim Ammons

Certificate of Completion by: Wesley Sparks R.S. date 9/9/97

Operation Permit by: Wesley Sparks RS date 9/9/97

HEALTH DEPT. COPY: WHITE INSPECTION COPY (FINAL): GREEN OWNER COPY (FINAL): YELLOW INSPECTION COPY (INITIAL): PINK OWNER COPY (INITIAL): GOLD