IREDELL COUNTY HEALTH DEPARTMENT

STATESVILLE 704-878-5305 150,00 Fa;d MOORESVILLE 704-664-5281

IMPROVEMENT PERMIT / AUTHORIZATION TO CONSTRUCT / OPERATION PERMIT / EXISTING SYSTEM INSPECTION

PERMIT# 130051 PIN# 4637-26-0846 DATE 8/11/05

OWNER OR CONTRACTOR Michael + Shawn Chapman PHONE: Business _____ Home _____

ADDRESS 110 Little Chapman Ln Mooresville NC 28117

LOCATION 150 W, TL McCrary, on Rt #260

SUBDIVISION _____ BLOCK / SECTION _____ LOT _____ LOT AREA 0.577 Ac. SITE CLASS PS DESIGN FLOW 360 L.T.A.R. —

Septic Tank: 1000 Gallons; STB 1512 Date 8/4/05
Pump Tank: _____ Gallons; PT _____ Date _____
Pump Make: _____ Model _____ Serial No. _____
Nitrification Field: No Fields ____ Square Feet _____ Linear Feet _____
No Lines _____ Trench Width _____ Max Trench Bottom Depth _____ Gravel Depth _____

☐ New System ☐ Repair System Type: I, (II), III, IV, V, VI
System Description: Existing Gravel Beds
Repair System Description: _____
Maintenance Agreement Required: ☐ Yes ☒ No


☒ House/Mod. Home No. Bedrooms 3
☐ Mobile Home No. Bathrooms ____
☐ Business No. Employees ____
☐ Other _____
☐ Slab ☒ Crawl Space ☐ Basement w/plumbing ☐ Basement wo/plumbing

Water Supply:
☒ Individual
☐ Public
☐ Community


Comments:/Conditions:

Comments:/Conditions:

INITIAL SITE SKETCH

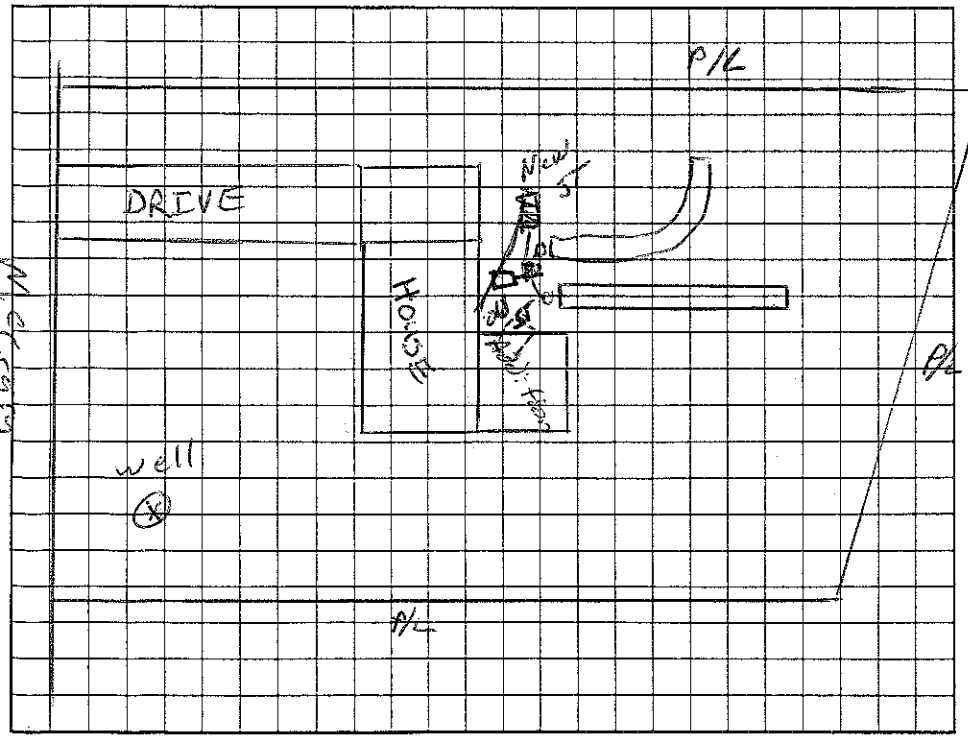

AS BUILT SKETCH

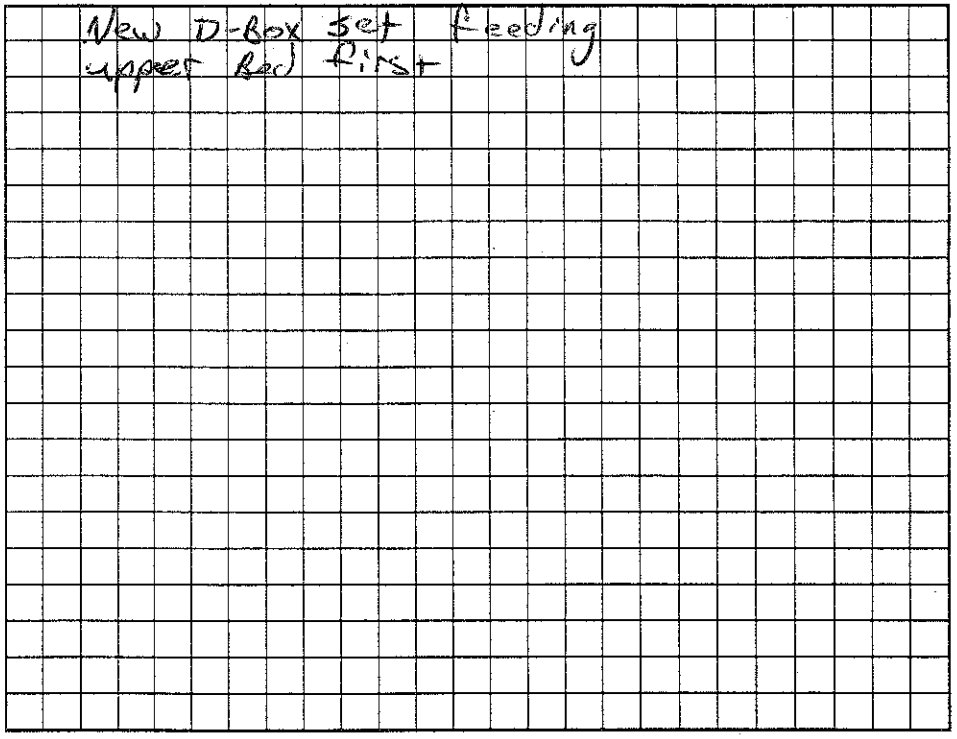

Permit can be suspended or revoked if any false information is supplied toward securing the permit/any unauthorized changes are made to the site/any unauthorized changes are made in the installation of the system. Improvement Permit with plat valid without expiration. Improvement Permit with site plan valid for sixty months. Authorization to Construct is valid for a period equal to that of Improvement Permit – not to exceed sixty months.

Signed: S M Chapman date 8/11/05 Installed by: Tommy Frye

Improvement Permit by: RS date 8/11/05 Operation Permit by: RS date 9/22/05

Authorization to Construct by: RS date 8/11/05 Existing System Inspection by: _____ date _____

HEALTH DEPT. COPY: WHITE OWNER COPY (FINAL): YELLOW OWNER COPY (INITIAL): PINK