IREDELL COUNTY HEALTH DEPARTMENT

Statesville Office (704) 878-5305 Mooresville Office (704) 660-3625 PERMIT # 218827

IMPROVEMENT PERMIT / AUTHORIZATION TO CONSTRUCT / OPERATION PERMIT / EXISTING SYSTEM

PIN # 4637-26-1111

APPLICANT: SHAWN GEHRING APPLICANT ADDRESS: 120 RIVERWOOD RD. - MOORESVILLE

SITE ADDRESS: SAME PHONE: 215-990-9252 ALT. PHONE:

SITE DIRECTIONS: I50, TL MCCRARY, TL RIVERWOOD, ON L

SUBDIVISION: RIVERWOOD BEND SECTION: — LOT # 3 LOT AREA: .677 AC DESIGN FLOW: 480 L.T.A.R.: .3

Septic Tank Ex. 1000 (gal) STB Date

Pump Tank Ex. 1500 (gal) PT Date

Pump Make Model Serial #

Nitrification Fields # Lines Linear Ft: EXISTING

Trench Width Max. Trench Bottom Depth Gravel Depth

☐ New System ☐ Repair ☐ Expansion System Type: I II III ☒ IV V VI

System Description: LP- PANEL BLOCK

Repair System Description: SAME

Maintenance Agreement Required: ☒ YES ☐ NO

☐ GRAVITY ☒ PRESSURE

☐ Residence ☐ Business ☒ Other ☐ Slab ☐ Basement w/plumbing

No. Bedrooms 4 No. Persons 8 No. Employees

☒ Crawl Space ☐ Basement w/o plumbing


Water Supply: ☒ Private ☐ Public ☐ Community

Comments / Conditions:

20' PORCH ADDITION

INITIAL SITE SKETCH

AS BUILT SKETCH

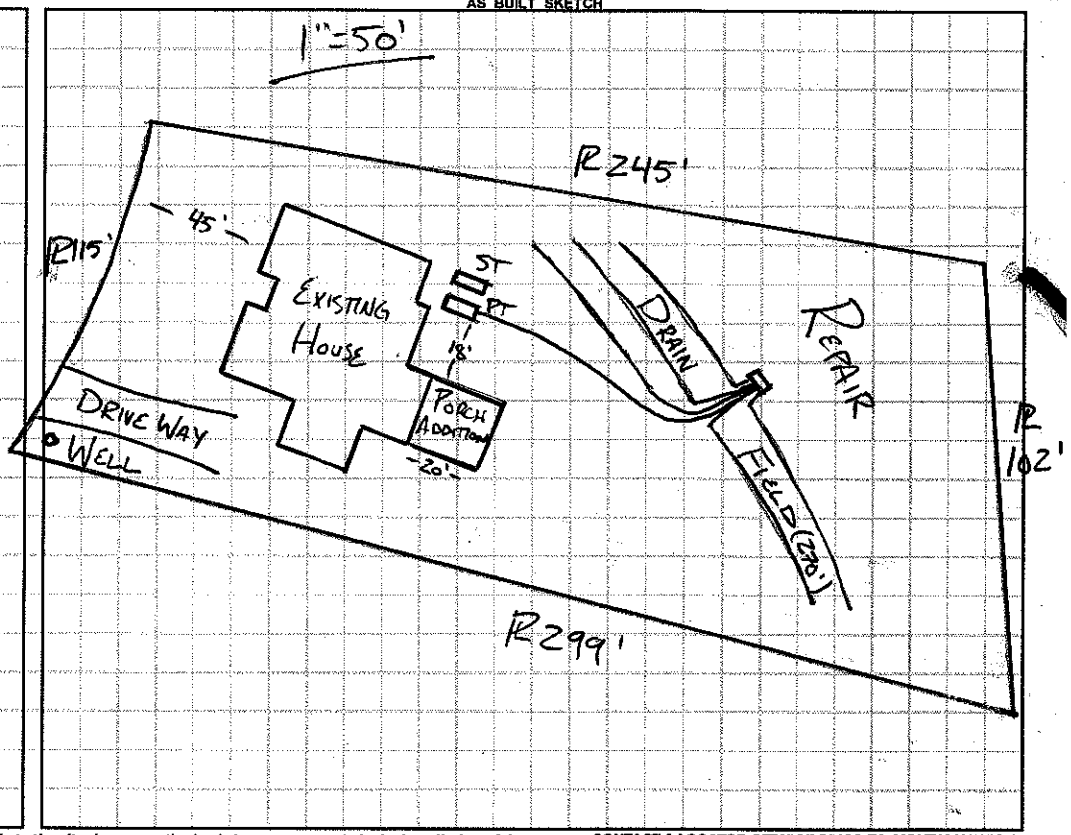

Permit can be suspended or revoked if any false information is supplied toward securing the permit / any unauthorized changes are made to the site / any unauthorized changes are made in the installation of the system. **CONTACT A LOCATOR SERVICE PRIOR TO ANY EXCAVATION**

☐ **IMPROVEMENT PERMIT** *with plat valid without expiration* ☐ **IMPROVEMENT PERMIT** *with site plan valid for 60 mos.* ☐ **AUTHORIZATION TO CONSTRUCT** *valid for period equal to IMPROVEMENT PERMIT--not to exceed 60 mo.*

Owner / Applicant Signature: Date: 6/27/16 Installed by:

IMPROVEMENT PERMIT by: Date: OPERATION PERMIT by: Date:

AUTHORIZATION TO CONSTRUCT by: Date: Existing System Inspected by: Date: APPROVED JUN 24 2016

Health Dept. Copy - WHITE Applicant (Final Approval) - YELLOW Applicant (Conditional Approval) - PINK