IREDELL COUNTY HEALTH DEPARTMENT

STATESVILLE 704-878-5305 MOORESVILLE 704-664-5281

IMPROVEMENT PERMIT / AUTHORIZATION TO CONSTRUCT / OPERATION PERMIT / EXISTING SYSTEM INSPECTION

PERMIT# 122848 PIN# 4637306101 Dennis DATE 7-7-05

OWNER OR CONTRACTOR Niplock Dev Corp PHONE: Business 361-7401 Home

ADDRESS 300 Mc Gill Ave Concord NC 28027

LOCATION Bowley School Rd TR Blume TR Hegons Gate TL Harrison Pt on left at end

SUBDIVISION Edgewater Pk BLOCK / SECTION 3 LOT 27 LOT AREA .85 Acre SITE CLASS PS DESIGN FLOW 480gpd L.T.A.R. .3

Septic Tank: 1000 Gallons; STB 794 Date 5-28-05
Pump Tank: Gallons; PT Date
Pump Make: Model Serial No.
Nitrification Field: No Fields 1 Square Feet 1215 Linear Feet 405'
No Lines 3@135' Trench Width 36" Max Trench Bottom Depth 36" Gravel Depth N/A

☒ New System ☐ Repair System Type: I, II, III, IV, V, VI
System Description: Gravity - 25% Reduction
Repair System Description: Pump/Gravity 25% Reduction
Maintenance Agreement Required: ☐ Yes ☒ No


☒ House/Mod. Home No. Bedrooms 4
☐ Mobile Home No. Bathrooms
☐ Other No. Employees
☐ Slab ☒ Crawl Space ☐ Basement w/plumbing ☐ Basement wo/plumbing

Water Supply: ☒ Individual ☐ Public ☐ Community


Comments:/Conditions: Keep Septic System at least 10' from PL

Comments:/Conditions: Must keep "Future Garage" & 10' off Septic System

INITIAL SITE SKETCH Scale 1:50'

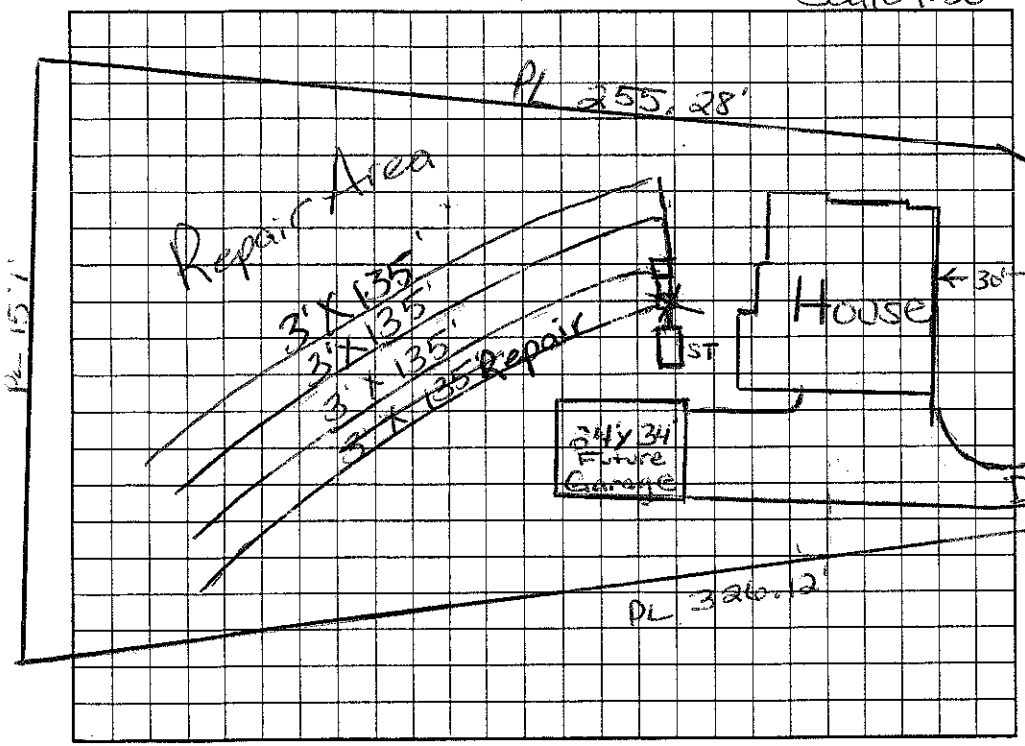

AS BUILT SKETCH

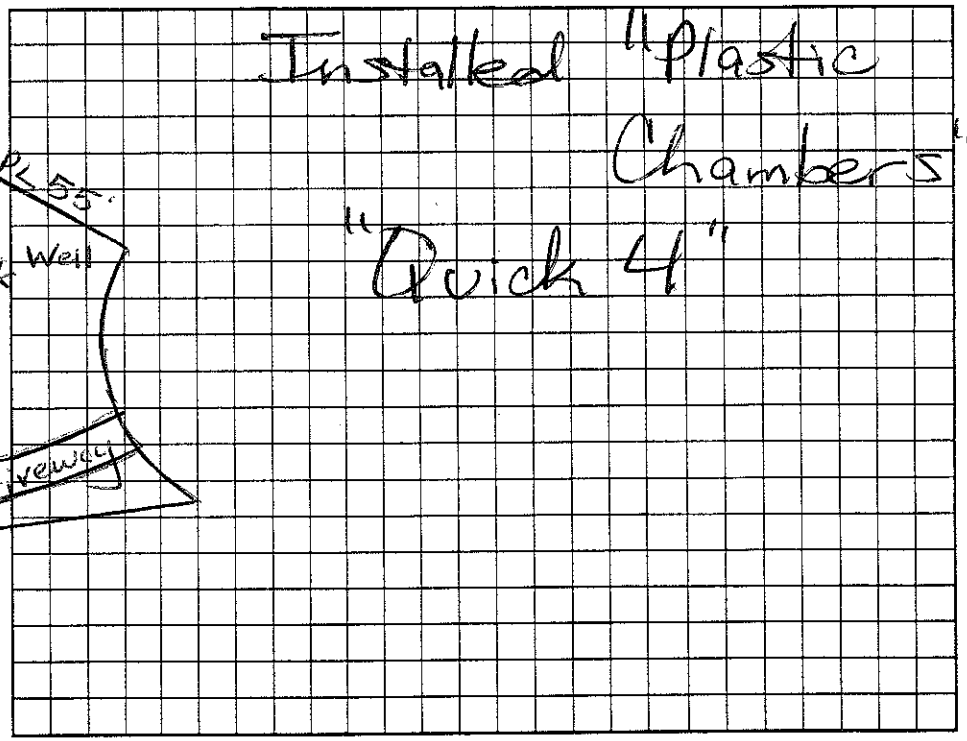

Permit can be suspended or revoked if any false information is supplied toward securing the permit/any unauthorized changes are made to the site/any unauthorized changes are made in the installation of the system. Improvement Permit with plat valid without expiration. Improvement Permit with site plan valid for sixty months. Authorization to Construct is valid for a period equal to that of Improvement Permit – not to exceed sixty months.

Signed: RS date

Improvement Permit by: Maria H. Colon RS date 7/7/05

Authorization to Construct by: Maria H. Colon RS date 7/7/05

Installed by: Richard Abercrombie

Operation Permit by: Maria H. Colon RS date 7/11/05

Existing System Inspection by: date

HEALTH DEPT. COPY: WHITE OWNER COPY (FINAL): YELLOW OWNER COPY (INITIAL): PINK