IREDELL COUNTY HEALTH DEPARTMENT

STATESVILLE 704-878-5305 MOORESVILLE 704-664-5281

IMPROVEMENT PERMIT / AUTHORIZATION TO CONSTRUCT / OPERATION PERMIT / EXISTING SYSTEM INSPECTION

PERMIT# 122849 PIN# 4637-30-6197 DATE Nov 18, 04

OWNER OR CONTRACTOR Niblock Dev Corp PHONE: Business Home

ADDRESS 300 McGill Ave Concord N.C. 28027

LOCATION Brawley Sch Rd. TR Blume TR Herrons Gate TL Harrison Pt Ct. at end

SUBDIVISION Edgewater Park BLOCK / SECTION B LOT 28 LOT AREA 1.2 ac SITE CLASS. PS DESIGN FLOW 440gpd L.T.A.R. 0.3

Septic Tank: 1000 Gallons; STB 794 Date 7/5/05

Pump Tank: ~~1000~~ Gallons; PT Date

Pump Make: Model Serial No.

Nitrification Field: No Fields 1 Square Feet 800 Linear Feet 480

No Lines 3 Trench Width 36" Max Trench Bottom Depth 36" Gravel Depth NR

☑ New System ☐ Repair System Type: I II III IV V VI

System Description: ~~25%~~ 25% Reduction

Repair System Description: 25% Reduction

Maintenance Agreement Required: ☐ Yes ☐ No

☐ House/Mod. Home No. Bedrooms 4

☐ Mobile Home No. Bathrooms

☐ Business No. Employees

☐ Other


☐ Slab ☐ Crawl Space ☑ Basement w/plumbing ☐ Basement wo/plumbing

Water Supply: ☑ Individual ☐ Public ☐ Community


Comments/Conditions: 224.30'

Comments/Conditions: 84.92'

INITIAL SITE SKETCH

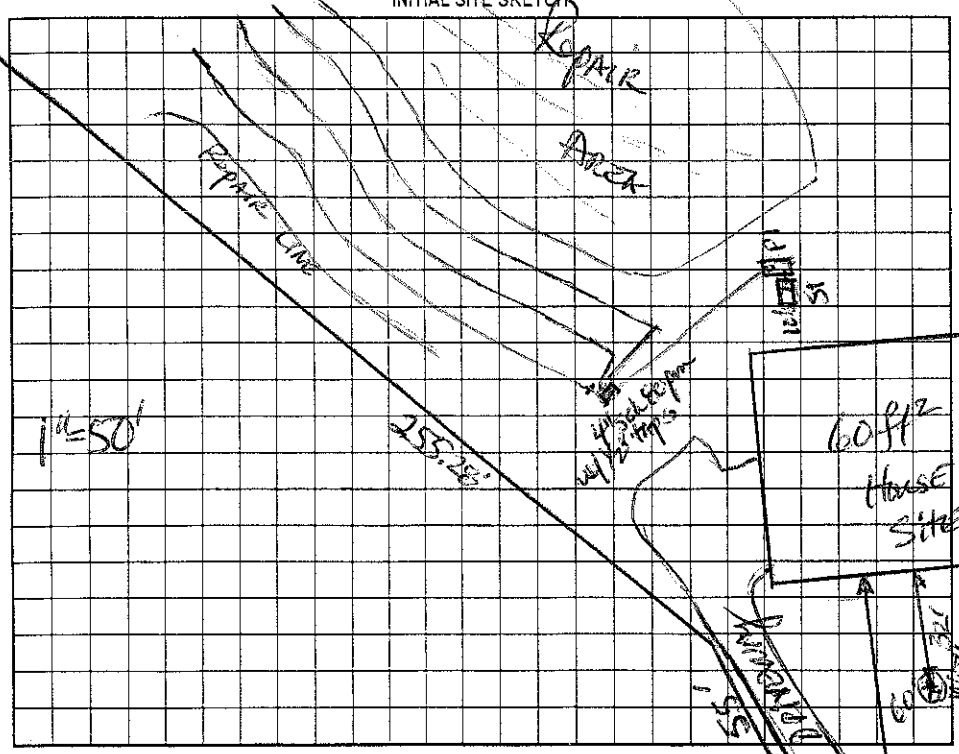

AS BUILT SKETCH

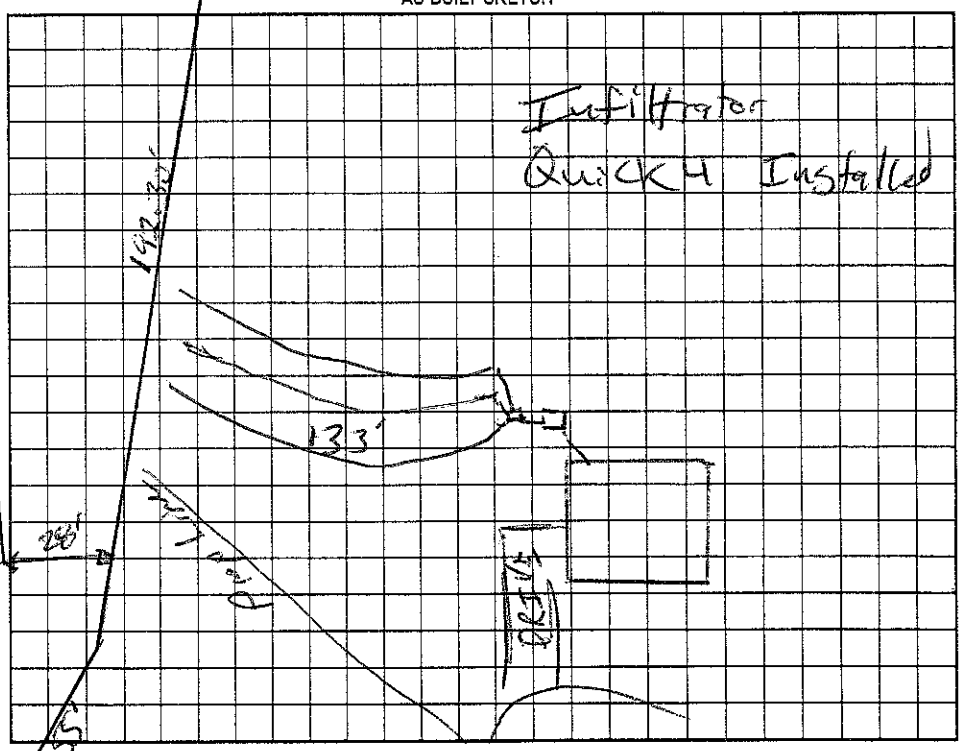

Permit can be suspended or revoked if any false information is supplied toward securing the permit, any unauthorized changes are made to the site/any unauthorized changes are made in the installation of the system. Improvement Permit with plat valid without expiration. Improvement Permit with site plan valid for sixty months. Authorization to Construct is valid for a period equal to that of Improvement Permit – not to exceed sixty months.

Signed: Pat Carpenter 3-1-05 date RW Harrison Pt Ct Installed by: Abernathy

Improvement Permit by: DHuffman RS date 11-18-04 Operation Permit by: RS date 8/9/05

Authorization to Construct by: Wesley Perkins date 4/18/05 Existing System Inspection by: date

HEALTH DEPT. COPY: WHITE OWNER COPY (FINAL): YELLOW OWNER COPY (INITIAL): PINK