IREDELL COUNTY HEALTH DEPARTMENT

4637307837

STATESVILLE 704-878-5305 MOORESVILLE 704-664-5281

IMPROVEMENT PERMIT / CERTIFICATE OF COMPLETION / OPERATION PERMIT / EXISTING SYSTEM INSPECTION

PROPERTY DESCRIPTION NO. 18437 DATE May 10, '94 TAX MAP NO. 2L5A182C

OWNER OR CONTRACTOR James McKumle PHONE: Business _____ Home _____ Watershed: ☑ Yes ☐ No

ADDRESS 9602 Jonah Ridge, Cleveland Rapid N.C. L.N.

LOCATION 1100 TR Blume TR Patternotte 2nd from end on left

SUBDIVISION Crescent LA BLOCK / SECTION 9 LOT 1503 LOT AREA 1.36Ac SITE CLASS. _____ DESIGN FLOW 360 gpd L.T.A.R. _____

Septic Tank: EXISTING Gallons; STB _____ Date _____

Pump Tank: _____ Gallons; PT _____ Date _____

Pump Make: _____ Model _____ Serial No. _____

Nitrification Field: No Fields EXISTING Square Feet _____ Linear Feet _____

No Lines _____ Trench Width _____ Max Trench Bottom Depth _____ Gravel Depth _____

☐ New System ☐ Repair System Type: I, II, III, IV, V, VI

System Description: gravity conventional

Repair System Description: _____

Maintenance Agreement Required: ☐ Yes ☑ No

☐ House/Mod. Home No. Bedrooms 2

☑ Mobile Home No. Bathrooms 2

☐ Business No. Employees _____

☐ Other _____


☐ Slab ☐ Crawl Space ☐ Basement w/plumbing ☐ Basement wo/plumbing

Water Supply: ☑ Individual ☐ Community ☐ Public


Comments: Existing system showing no signs of malfunction. Mobile home being replaced. New mobile home not on site.

Comments:

INITIAL SITE SKETCH

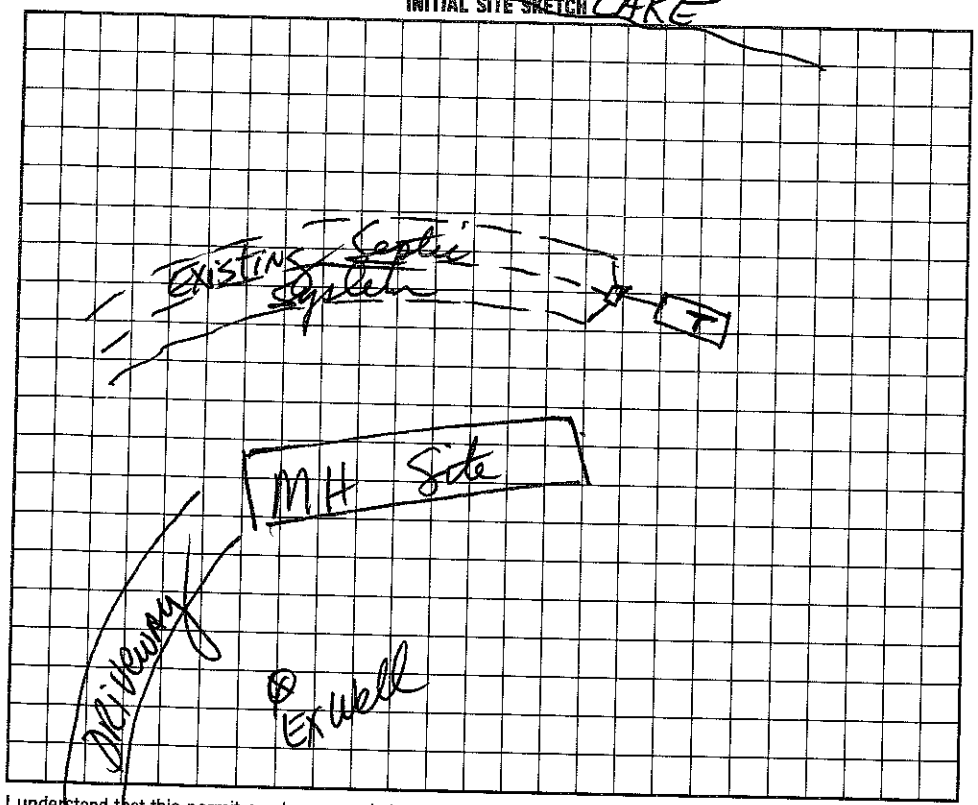

AS BUILT SKETCH

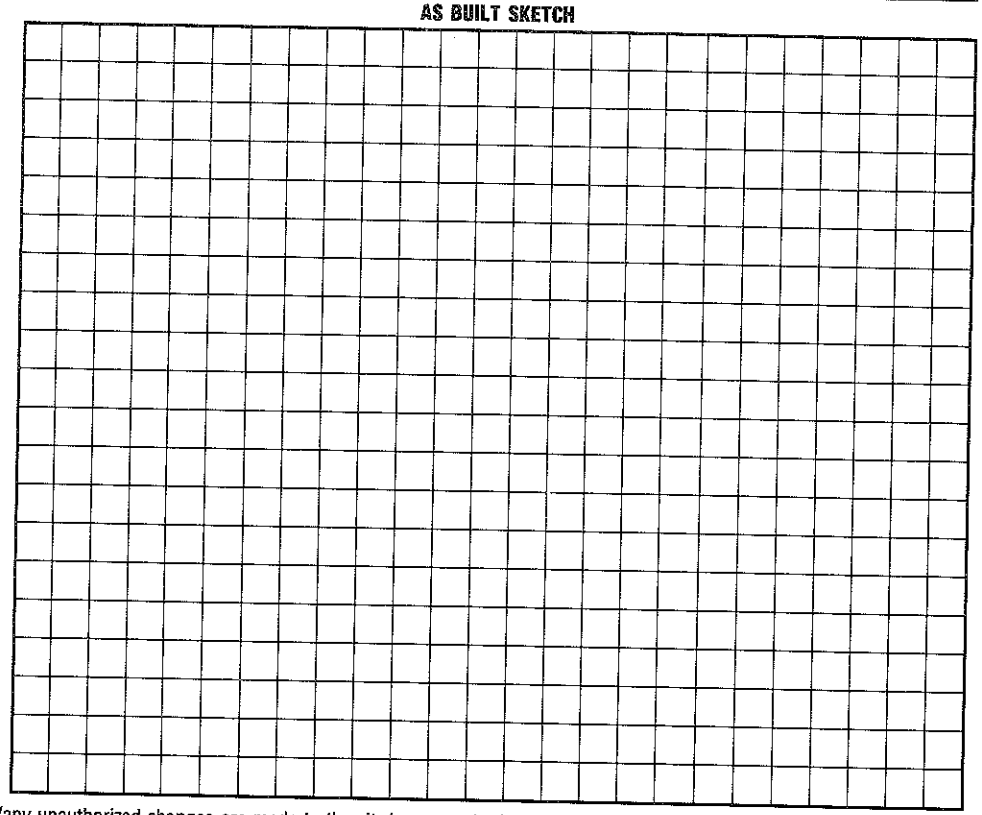

I understand that this permit can be suspended or revoked if any false information is supplied toward securing the permit/any unauthorized changes are made to the site/any unauthorized changes are made in the installation of the system. Improvement Permit is valid for 60 months from date of issuance.

Signed: Patternotte

Improvement Permit by: _____ date _____

Existing System Inspection by: [signature] date 5/10/94

Installed by: _____

Certificate of Completion by: _____ date _____

Operation Permit by: _____ date _____

HEALTH DEPT. COPY: WHITE INSPECTION COPY (FINAL): GREEN OWNER COPY (FINAL): YELLOW INSPECTION COPY (INITIAL): PINK OWNER COPY (INITIAL): GOLD