IREDELL COUNTY HEALTH DEPARTMENT

STATESVILLE 704-878-5305 $375 MOORESVILLE 704-664-5281 2130

IMPROVEMENT PERMIT / AUTHORIZATION TO CONSTRUCT / OPERATION PERMIT / EXISTING SYSTEM INSPECTION

PERMIT# 120659 PIN# 4637 30 7837 DATE 9/30/04

OWNER OR CONTRACTOR James Kumle PHONE: Business ABJ / 664-4353 Home

ADDRESS 9602 Jonah Ridge Statesville NC 28677

LOCATION 1100 TR Blume TR Patternote Rd. to # 319 on (L), 1st past Paula's Parkway

SUBDIVISION CL+T BLOCK / SECTION 9 LOT 182C LOT AREA 1.3 AC SITE CLASS PS DESIGN FLOW 360 L.T.A.R. .3

Septic Tank: 1000 Gallons; STB 312 Date 8/24/05
Pump Tank: 1000 Gallons; PT 283 Date 8/22/05
Pump Make: Goulds Model WE0 712 HT Serial No. 3/4/05
Nitrification Field: No Fields 1 Square Feet 400/600 Linear Feet 200
No Lines 4@50' Trench Width 2-3' Max Trench Bottom Depth 32" Gravel Depth No

[X] New System [ ] Repair System Type: I, II, III, (IV), V, VI
System Description: Pres Dosed 16" PPBPS
Repair System Description: Same Type
Maintenance Agreement Required: [X] Yes [ ] No PATRIAL


[X] House/Mod. Home No. Bedrooms 3
[ ] Mobile Home No. Bathrooms 3
[ ] Business No. Employees
[ ] Other
[ ] Slab [ ] Crawl Space [X] Basement w/plumbing [ ] Basement wo/plumbing

Water Supply: [X] Individual [ ] Public [ ] Community


Comments:/Conditions: Original well must be properly abandoned and relocated as shown on this permit
1"=60'
CO53749

Comments:/Conditions:

INITIAL SITE SKETCH

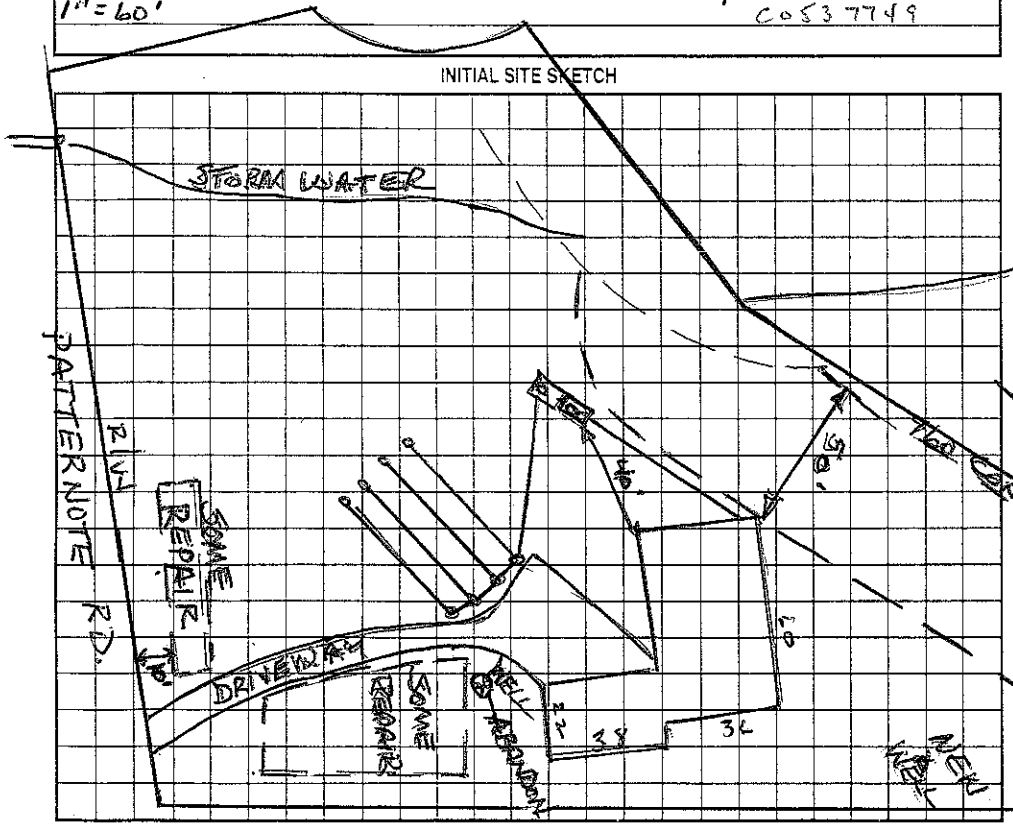

AS BUILT SKETCH

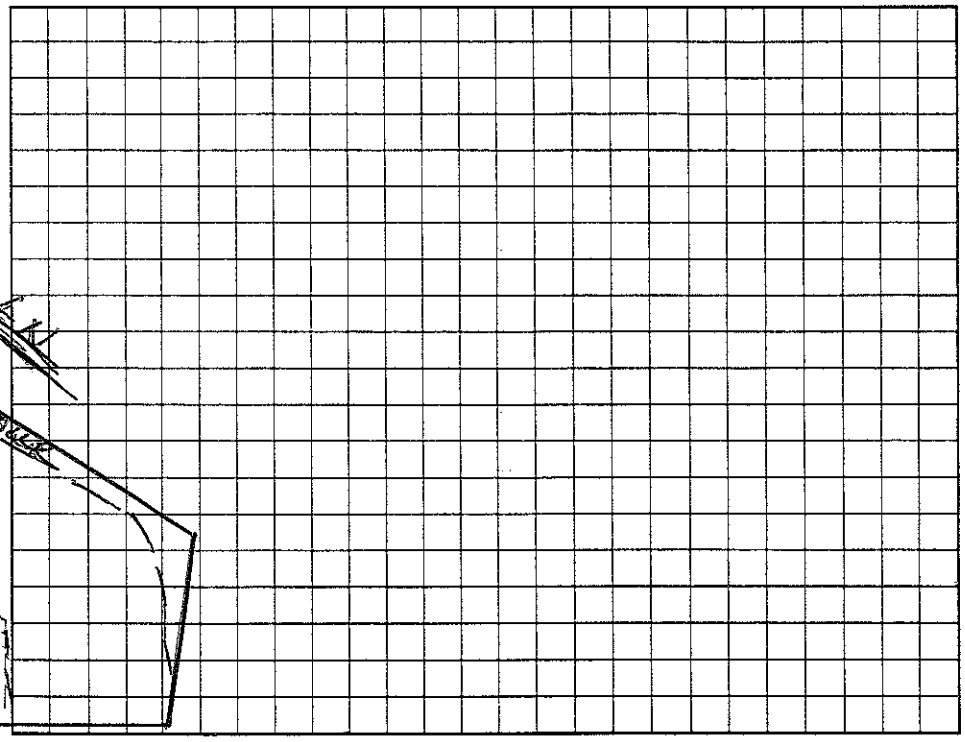

Permit can be suspended or revoked if any false information is supplied toward securing the permit/any unauthorized changes are made to the site/any unauthorized changes are made in the installation of the system. Improvement Permit with plat valid without expiration. Improvement Permit with site plan valid for sixty months. Authorization to Construct is valid for a period equal to that of Improvement Permit – not to exceed sixty months.

Signed: ABJ By KC date

Improvement Permit by: Wesley Sparks R.S. date 9/30/04

Authorization to Construct by: Wesley Sparks R.S. date 9/30/04

Installed by: E.J. Irwin

Operation Permit by: Wesley Sparks R.S. date 11/1/05

Existing System Inspection by: date

HEALTH DEPT. COPY: WHITE OWNER COPY (FINAL): YELLOW OWNER COPY (INITIAL): PINK