IREDELL COUNTY HEALTH DEPARTMENT

STATESVILLE 704-878-5305 MOORESVILLE 704-664-5281

IMPROVEMENT PERMIT / AUTHORIZATION TO CONSTRUCT / OPERATION PERMIT / EXISTING SYSTEM INSPECTION

PERMIT# 122851 PIN# 4637-30-9124 DATE Nov. 29, 04

OWNER OR CONTRACTOR Nicholas Dev. Corp. PHONE: Business Home

ADDRESS 300 McGill Ave. Concord, N.C. 28027

LOCATION Brawley Sch Rd. TR Blume TR Herons Gate Dr. TL Harrison Pt Ct. at end

SUBDIVISION Edgewater Park BLOCK / SECTION LOT 29/29A LOT AREA 1.009Ac + .769Ac SITE CLASS. PS SFE DESIGN FLOW 480gpd L.T.A.R. e3 SFE 29A

Septic Tank: 1000 Gallons; STB 794 Date 10-31-05

Pump Tank: 1000 Gallons; PT 27 Date 5-13-06

Pump Make: Gould's Model WED-15(2) Serial No.

Nitrification Field: No Fields 1 Square Feet 1200 Linear Feet 400

No Lines 4@100' Trench Width 36" Max Trench Bottom Depth 36" Gravel Depth NA

☑ New System ☐ Repair System Type: I, II, (III), IV, V, VI

System Description: pm 25% Reduction on SFE 29A

Repair System Description: Stone

Maintenance Agreement Required: ☐ Yes ☑ No

☑ House/Mod. Home ☐ Mobile Home ☐ Business ☐ Other

No. Bedrooms 4 No. Bathrooms No. Employees


☐ Slab ☐ Crawl Space ☑ Basement w/plumbing ☐ Basement wo/plumbing

Water Supply: ☑ Individual ☐ Public ☐ Community

Comments:/Conditions:

Comments:/Conditions: Checked tanks 7/21/06 MO

1"=100' INITIAL SITE SKETCH

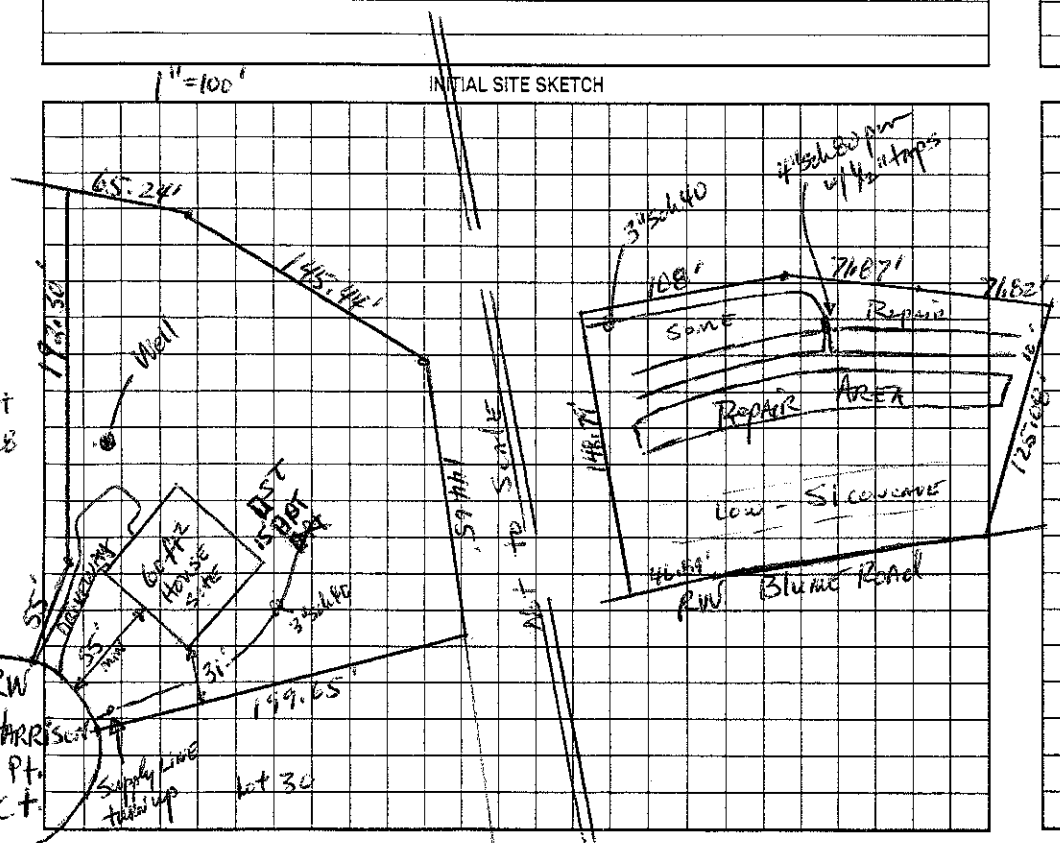

AS BUILT SKETCH

Permit can be suspended or revoked if any false information is supplied toward securing the permit/any unauthorized changes are made to the site/any unauthorized changes are made in the installation of the system. Improvement Permit with plat valid without expiration. Improvement Permit with site plan valid for sixty months. Authorization to Construct is valid for a period equal to that of Improvement Permit – not to exceed sixty months.

Signed: Pat Compton date 3-1-05 Installed by: Larry Hinkle

Improvement Permit by: [signature] date 11-29-04 Operation Permit by: Wesley Sparks RS. date 7/26/06

Authorization to Construct by: [signature] date 3-21-06 Existing System Inspection by: date

HEALTH DEPT. COPY: WHITE OWNER COPY (FINAL): YELLOW OWNER COPY (INITIAL): PINK