IREDELL COUNTY HEALTH DEPARTMENT

STATESVILLE 704-878-5305 MOORESVILLE 704-664-5281

IMPROVEMENT PERMIT / AUTHORIZATION TO CONSTRUCT / OPERATION PERMIT / EXISTING SYSTEM INSPECTION

PERMIT# 100292 PIN# 4637214601 (pt.) 4637310094 DATE July 9,01

OWNER OR CONTRACTOR Blume Road Partners II Edwards Court Inc. PHONE: Business _____ Home _____

ADDRESS 149 Yacht Cove Rd. Mooresville N.C. 28117

LOCATION Brawley Sch Rd. TR Blume TR Patternote on Right

SUBDIVISION Devonshire BLOCK / SECTION _____ LOT 42 LOT AREA 1.24 Ac SITE CLASS. PS DESIGN FLOW 480gpd L.T.A.R. .03

Septic Tank: 1000 Gallons; STB 794 Date 9/12/02
Pump Tank: 1000 Gallons; PT 27 Date 9/17/02
Pump Make: _____ Model _____ Serial No. _____
Nitrification Field: No Fields 1 Square Feet 1200 Linear Feet 400
No Lines 4 @ 100' Trench Width 36" Max Trench Bottom Depth 36" Gravel Depth NA

☑ New System ☐ Repair System Type: I, II, III, IV, V, VI
System Description: PM - Innovative - 25% Red.
Repair System Description: Same
Maintenance Agreement Required: ☐ Yes ☑ No

☑ House/Mod. Home No. Bedrooms 4
☐ Mobile Home No. Bathrooms 4
☐ Business No. Employees _____
☐ Other _____
☐ Slab ☑ Crawl Space ☐ Basement w/plumbing ☐ Basement wo/plumbing


Water Supply: ☑ Individual ☐ Public ☐ Community

Comments:/Conditions:


Comments:/Conditions: Installed "Plastic Chambers" for Drainfield
Pressure & electrical checked 4/22/03
Tanks & lines checked by GM 4/22/03

1" = 50'

INITIAL SITE SKETCH

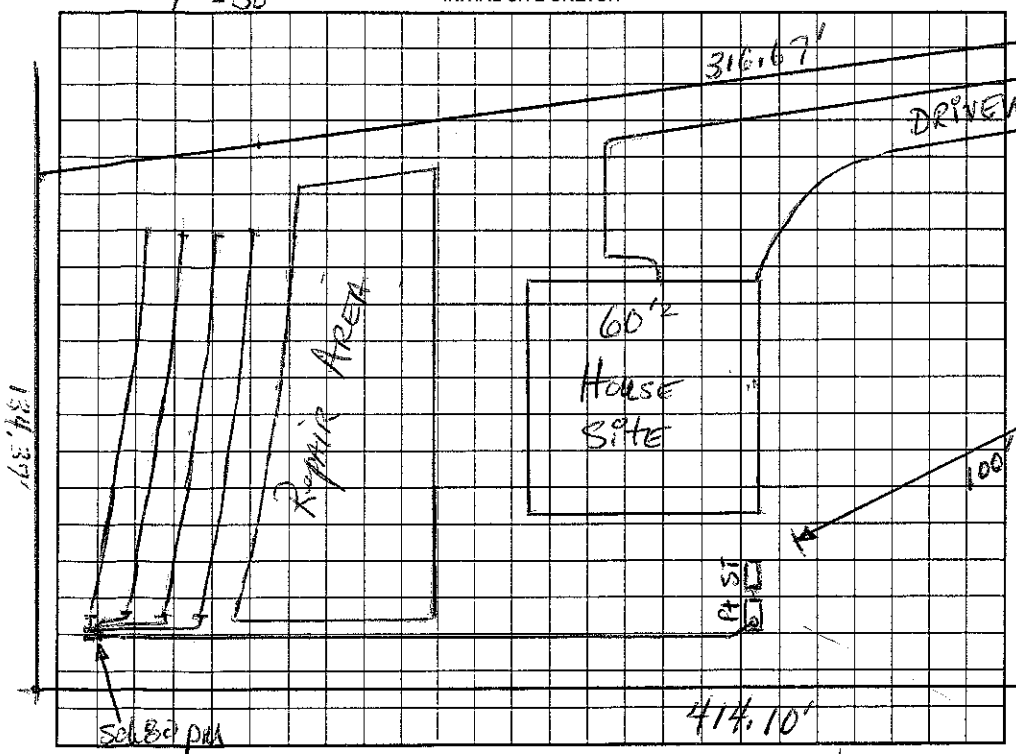

AS BUILT SKETCH

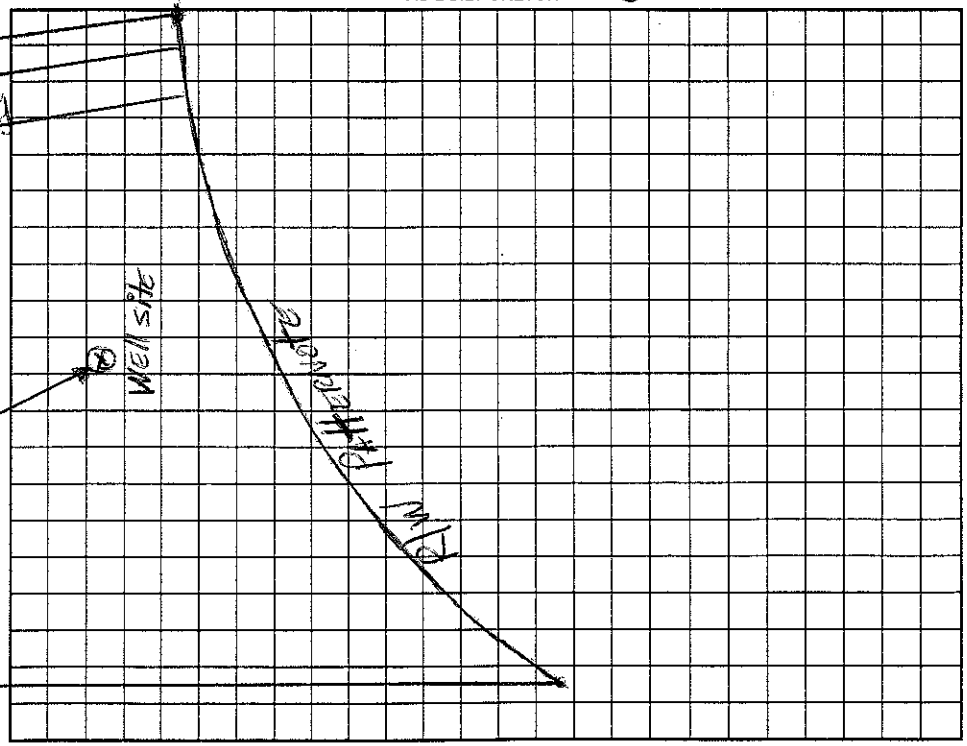

Permit can be suspended or revoked if any false information is supplied toward securing the permit/any unauthorized changes are made to the site/any unauthorized changes are made in the installation of the system. Improvement Permit with plat valid without expiration. Improvement Permit with site plan valid for sixty months. Authorization to Construct is valid for a period equal to that of Improvement Permit – not to exceed sixty months.

Signed: _____ date 7.17.01 Installed by: Abe-natty

Improvement Permit by: Mark Hyman, RS date 7-9-01 Operation Permit by: Maria H Dotson RS date 4/22/03

Authorization to Construct by: Mark Hyman RS date 5-23-02 Existing System Inspection by: _____ date _____

HEALTH DEPT. COPY: WHITE OWNER COPY (FINAL): YELLOW OWNER COPY (INITIAL): PINK