IREDELL COUNTY HEALTH DEPARTMENT

Statesville Office (704) 878-5305 Mooresville Office (704) 660-3625 PERMIT # REPAIR

IMPROVEMENT PERMIT / AUTHORIZATION TO CONSTRUCT / OPERATION PERMIT / EXISTING SYSTEM

PIN # 4637-31-1794

APPLICANT: RICHARD POPE APPLICANT ADDRESS: 263 PATTERNOTE RD

SITE ADDRESS: SAME PHONE: 704-576-2287 ALT. PHONE:

SITE DIRECTIONS: BSR, BLUME, PATTERNOTE, ON L

SUBDIVISION: CLET SECTION: 9 LOT # 174 LOT AREA: .67 AC DESIGN FLOW: L.T.A.R.:

Septic Tank 1000 (gal) STB NFILTRATOR Date

Pump Tank (gal) PT Date

Pump Make Model Serial #

Nitrification Fields # Lines Linear Ft:

Trench Width Max. Trench Bottom Depth EXISTING Gravel Depth

☐ New System ☒ Repair ☐ Expansion System Type: I II III IV V VI

System Description: REPLACE TANK

Repair System Description:

Maintenance Agreement Required: ☐ YES ☒ NO

☒ GRAVITY ☐ PRESSURE


☒ Residence ☐ Business ☐ Other ☐ Slab ☐ Basement w/plumbing

No. Bedrooms No. Persons No. Employees ☒ Crawl Space ☐ Basement w/o plumbing


Water Supply: ☒ Private ☐ Public ☐ Community

Comments / Conditions:

INITIAL SITE SKETCH

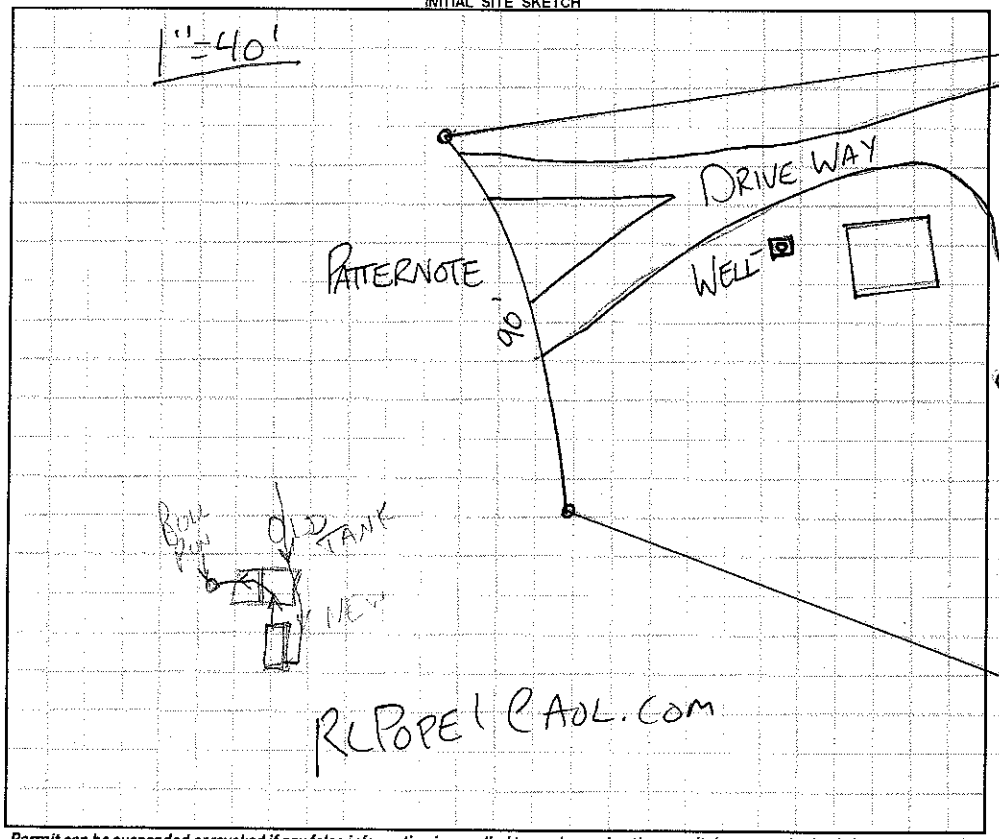

AS BUILT SKETCH

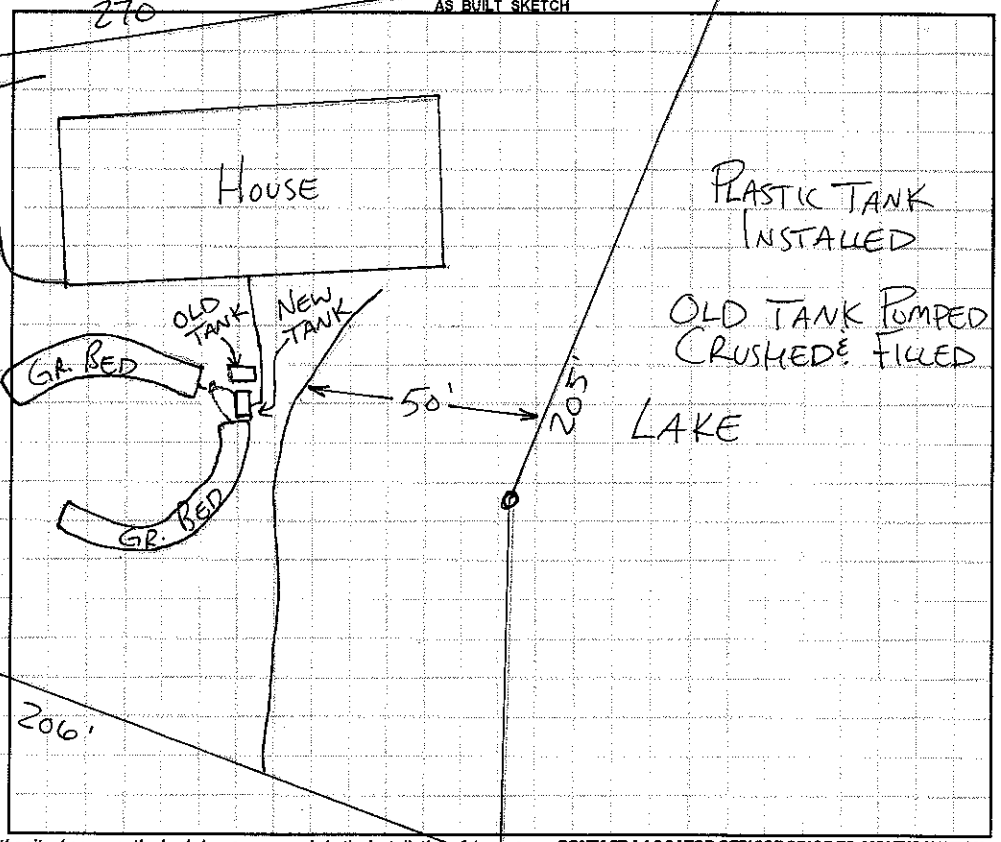

Permit can be suspended or revoked if any false information is supplied toward securing the permit / any unauthorized changes are made to the site / any unauthorized changes are made in the installation of the system. **CONTACT A LOCATOR SERVICE PRIOR TO ANY EXCAVATION**

☐ **IMPROVEMENT PERMIT** *with plat valid without expiration.* ☐ **IMPROVEMENT PERMIT** *with site plan valid for 60 mos.* ☒ **AUTHORIZATION TO CONSTRUCT** *valid for period equal to IMPROVEMENT PERMIT--not to exceed 60 mo.*

Owner / Applicant Signature: Date: 6-18-13 Installed by:

IMPROVEMENT PERMIT by: Date: 6-17-13 OPERATION PERMIT by: Date: 6-25-13

AUTHORIZATION TO CONSTRUCT by: Date: 6-17-13 Existing System Inspected by: Date:

Health Dept. Copy - WHITE Applicant (Final Approval) - YELLOW Applicant (Conditional Approval) - PINK