IREDELL COUNTY HEALTH DEPARTMENT

STATESVILLE 704-878-5305 MOORESVILLE 704-664-5281

IMPROVEMENT PERMIT / AUTHORIZATION TO CONSTRUCT / OPERATION PERMIT / EXISTING SYSTEM INSPECTION

PERMIT# ~~077258~~ 076426 PIN# 4637 31 7037 DATE 10/12/98

OWNER OR CONTRACTOR Jimmy & Whitley PHONE: Business 662-8552 Home

ADDRESS 114 Paulas Parkway Mooresville NC.

LOCATION 1100 TR Bluma TR Pa Hermote TL Paulas, (R) 125' driveway 114 Paulas Parkway

SUBDIVISION CL+T BLOCK / SECTION 9 LOT 181 LOT AREA .73Ac SITE CLASS. PS DESIGN FLOW 360 L.T.A.R. N/A

Septic Tank: EXISTING Gallons; STB Date

Pump Tank: 200 Gallons; PT Date

Pump Make: Model Serial No.

Nitrification Field: No Fields Square Feet Existing Linear Feet

No Lines Trench Width Max Trench Bottom Depth Gravel Depth

☐ New System ☐ Repair System Type: I, II, III, IV, V, VI

System Description: Adding Grinder Pump

Repair System Description:

Maintenance Agreement Required: ☐ Yes ☒ No

☒ House/Mod. Home No. Bedrooms 3

☐ Mobile Home No. Bathrooms 3

☐ Business No. Employees

☐ Other


☐ Slab ☐ Crawl Space ☒ Basement w/plumbing PARTIAL ☐ Basement wo/plumbing

Water Supply: ☒ Individual ☐ Public ☐ Community

Comments:/Conditions:

1" = 30'


INITIAL SITE SKETCH

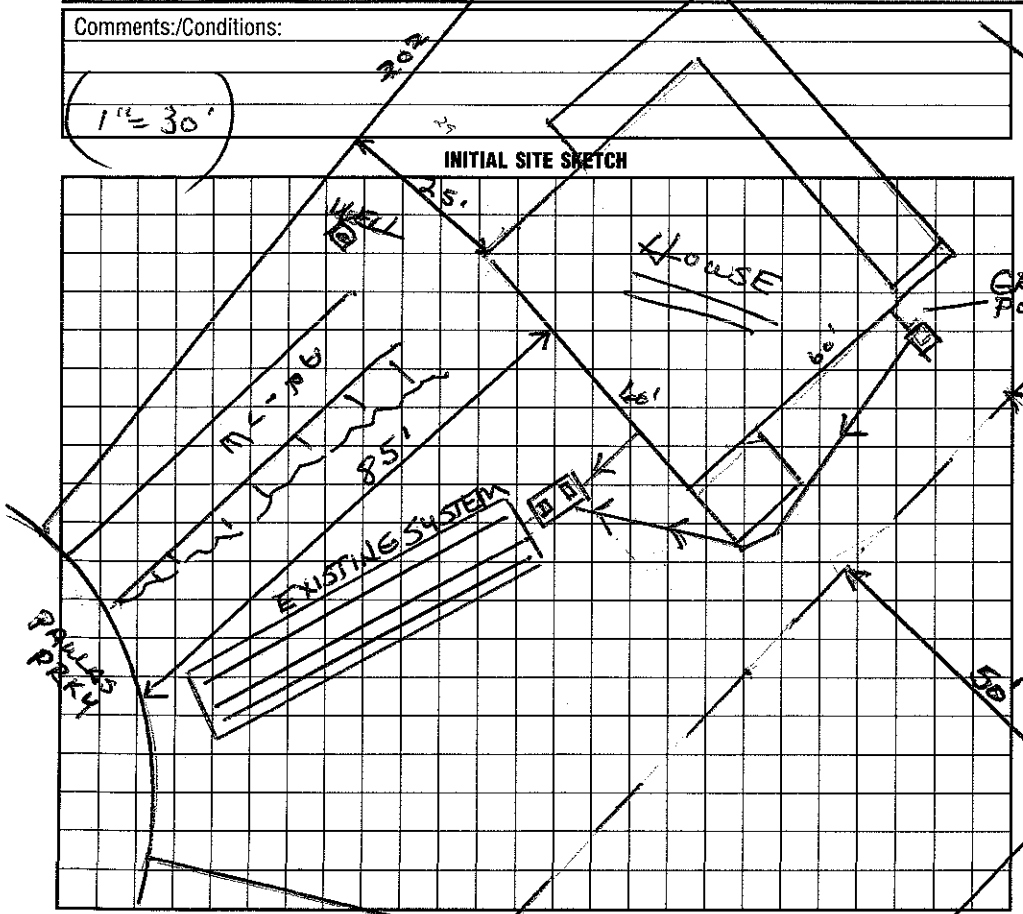

Comments:/Conditions:

50'

AS BUILT SKETCH

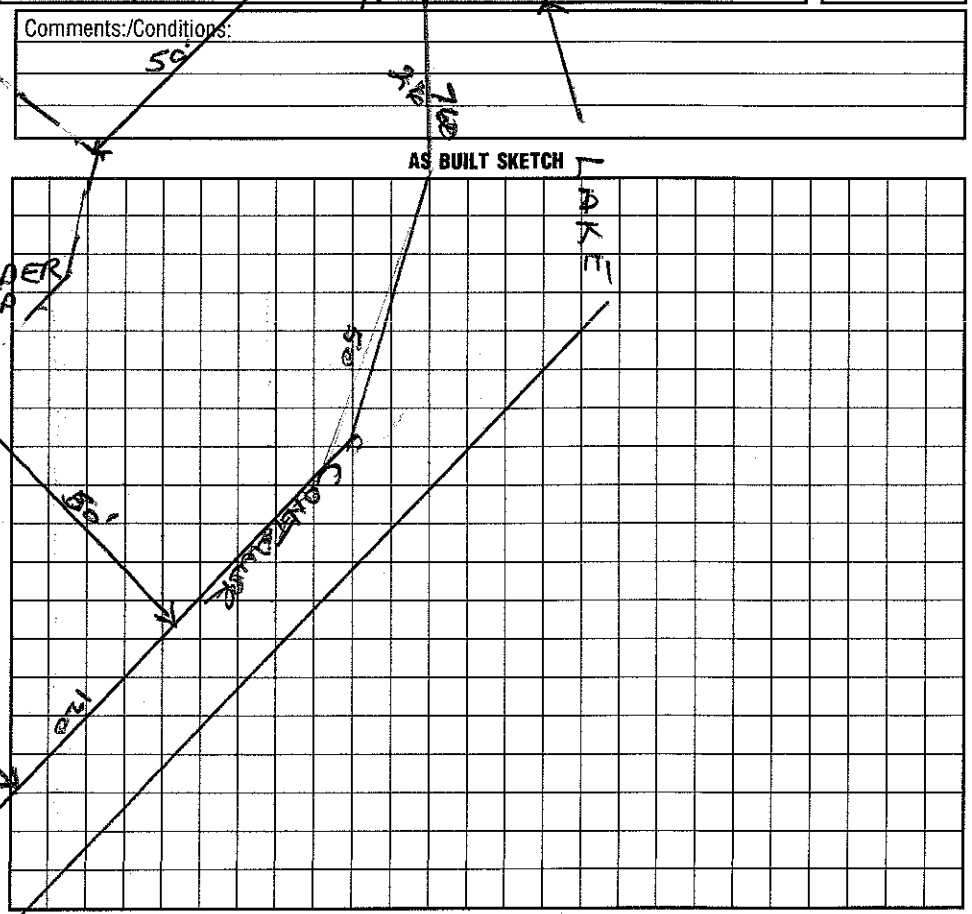

I understand that this permit can be suspended or revoked if any false information is supplied toward securing the permit/any unauthorized changes are made to the site/any unauthorized changes are made in the installation of the system. Improvement Permit with plat valid without expiration. Improvement Permit with site plan valid for sixty months. Authorization to Construct is valid for a period equal to that of Improvement Permit – not to exceed sixty months.

Signed: Cindy N. Whitley date 10/19/98

Improvement Permit by: Wesley Sparks RS date 10/12/98

Authorization to Construct by: Wesley Sparks RS. date 10/12/98

Installed by: Whitley Edgerton

Operation Permit by: Wesley Sparks RS. date 10/20/99

Existing System Inspection by: date

HEALTH DEPT. COPY: WHITE INSPECTION COPY (FINAL): GREEN OWNER COPY (FINAL): YELLOW INSPECTION COPY (INITIAL): PINK OWNER COPY (INITIAL): GOLD