4637326099

IREDELL COUNTY HEALTH DEPARTMENT

STATESVILLE 704-878-5305 MOORESVILLE 704-664-5281

IMPROVEMENT PERMIT / CERTIFICATE OF COMPLETION / OPERATION PERMIT / EXISTING SYSTEM INSPECTION

PROPERTY DESCRIPTION NO. 19056 DATE Feb 21, '95 TAX MAP NO. 2K6A216 Watershed: ☑ Yes ☐ No WS IV

OWNER OR CONTRACTOR William Musgrave PHONE: Business ______ Home ______

ADDRESS ______

LOCATION 1100 TR Oak Tree Rd. Bear left @ lake v.4 mile on Right

SUBDIVISION Crescent / LN BLOCK / SECTION 9 LOT 216 LOT AREA Existing SITE CLASS. ______ DESIGN FLOW ______ L.T.A.R. ______

Septic Tank: Existing Gallons; STB ______ Date ______
Pump Tank: ______ Gallons; PT ______ Date ______
Pump Make: ______ Model ______ Serial No. ______
Nitrification Field: No. Fields ______ Square Feet ______ Linear Feet ______
No Lines Existing Trench Width ______ Max Trench Bottom Depth ______ Gravel Depth ______

☐ New System ☐ Repair System Type: I, (II), III, IV, V, VI
System Description: ______
Repair System Description: ______
Maintenance Agreement Required: ☐ Yes ☐ No

☑ House/Mod. Home No. Bedrooms 3
☐ Mobile Home No. Bathrooms 3
☐ Business No. Employees ______
☐ Other ______


☐ Slab ☐ Crawl Space ☐ Basement w/plumbing ☐ Basement wo/plumbing

Water Supply:
☐ Individual
☐ Community
☐ Public

Comments: Replacing 3 bedroom MH w/ 3 bedroom house. No signs of system malfunction

Comments:

INITIAL SITE SKETCH

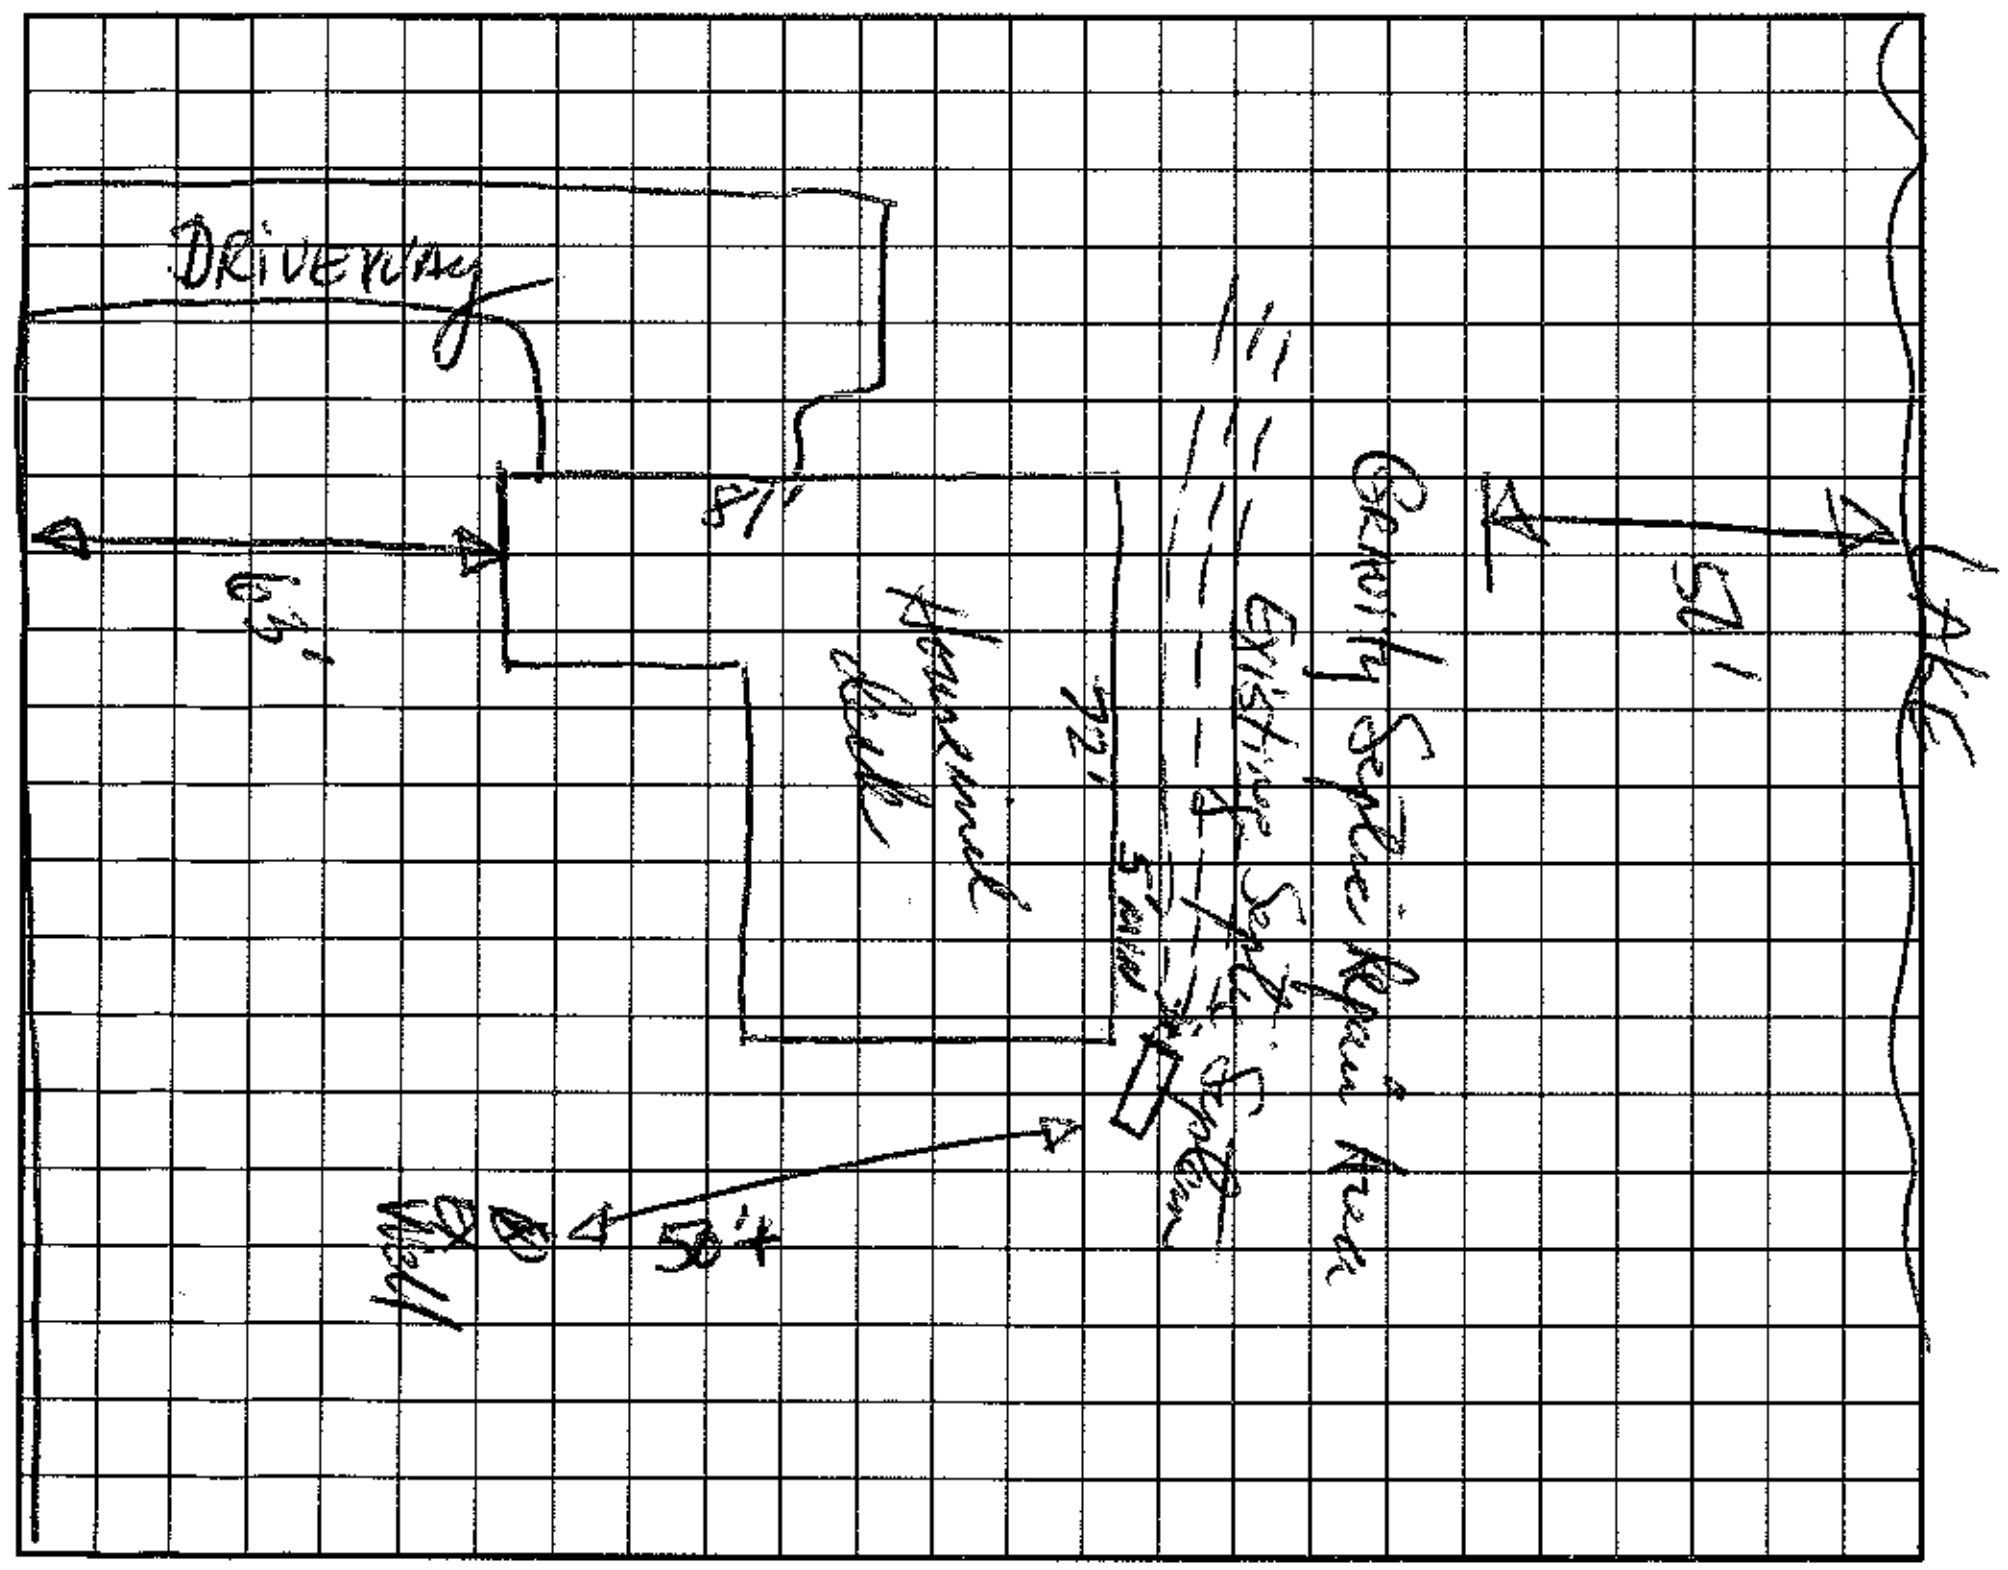

AS BUILT SKETCH

I understand that this permit can be suspended or revoked if any false information is supplied toward securing the permit/any unauthorized changes are made to the site/any unauthorized changes are made in the installation of the system. Improvement Permit is valid for 60 months from date of issuance.

Signed: ______ Installed by: ______

Improvement Permit by: ______ date ______ Certificate of Completion by: ______ date ______

Existing System Inspection by: [signature], RS date 2/21/95 Operation Permit by: ______ date ______

HEALTH DEPT. COPY: WHITE INSPECTION COPY (FINAL): GREEN OWNER COPY (FINAL): YELLOW INSPECTION COPY (INITIAL): PINK OWNER COPY (INITIAL): GOLD