[cut off: "…DELL"] COUNTY HEALTH DEPARTMENT

STATESVILLE 704-878-5305 130.00 Pd MOORESVILLE 704-664-5281

[cut off: "…ROVEMENT"] PERMIT / AUTHORIZATION TO CONSTRUCT / OPERATION PERMIT / EXISTING SYSTEM INSPECTION

PERMIT# 129613 PIN# 4637335143 DATE 8-25-05

OWNER OR CONTRACTOR Robert + Susan Dewey PHONE: Business 704-351-4443 Home 704-663-5955

ADDRESS 388 Oak Tree Rd. Mooresville 28117

LOCATION Brawley School Rd W TR Oak Tree approx. 1½ mi. on right

SUBDIVISION CL&T BLOCK / SECTION 9 LOT 224 LOT AREA .66 Ac SITE CLASS. PS DESIGN FLOW 360 gpd L.T.A.R. .3 gpd/ft²

Septic Tank: 1000 Gallons; STB 1012 Date 6-15-05
Pump Tank: ~~1000~~ Gallons; PT ______ Date ______
Pump Make: ______ Model ______ Serial No. ______
Nitrification Field: No Fields ______ Square Feet ______ Linear Feet ______
No Lines 5 @ 40' Trench Width 24" Max Trench Bottom Depth 36" Gravel Depth NA

☐ New System ☐ Repair System Type: I, II, (III), IV, V, VI
System Description: PPBPS pressure manifold
Repair System Description: LP panel
Maintenance Agreement Required: ☐ Yes ☒ No


☒ House/Mod. Home No. Bedrooms 3
☐ Mobile Home No. Bathrooms ______
☐ Business No. Employees ______
☐ Other ______
☐ Slab ☒ Crawl Space ☐ Basement w/plumbing ☐ Basement wo/plumbing

Water Supply:
☒ Individual
☐ Public
☐ Community

Comments:/Conditions: Existing well must be properly abandoned & documentation received before operation permit issued. Maintain storm water & Lake contour setbacks

Comments:/Conditions: Yellow tuff tite filter septic tank w/ marker

INITIAL SITE SKETCH

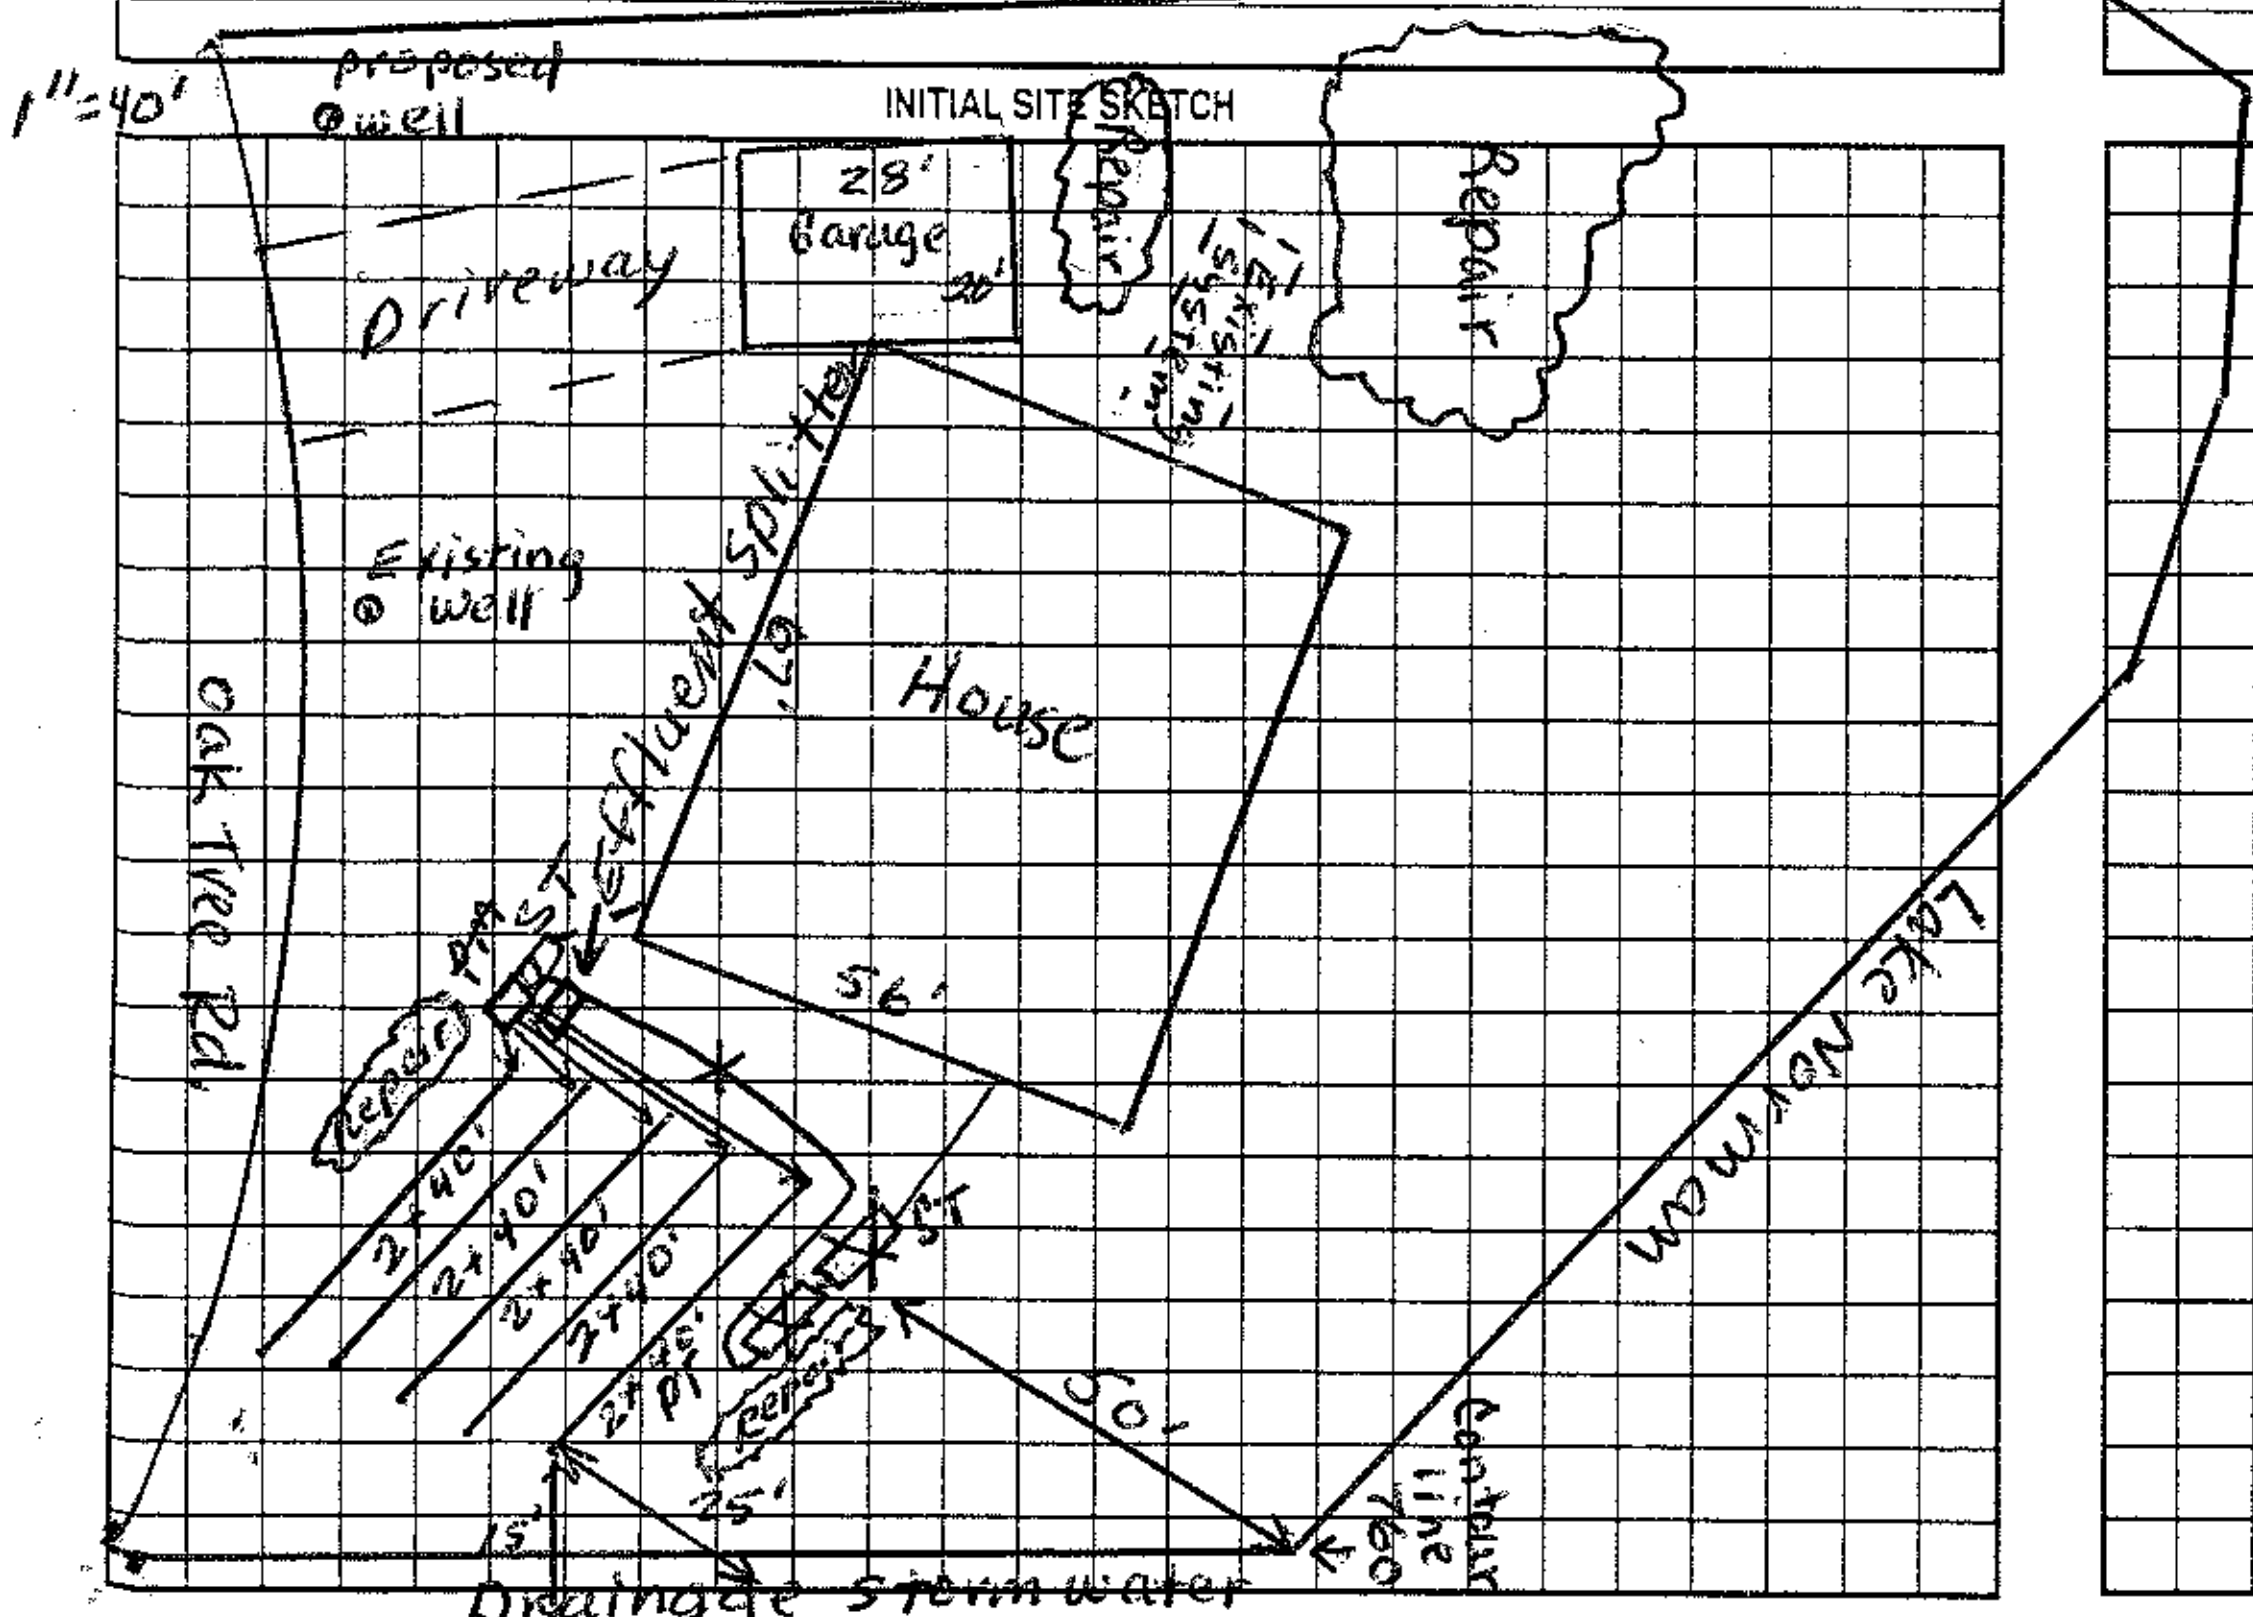

AS BUILT SKETCH

45 panels - 9 per trench installed

Gravity system installed as corrected on site sketch

Zoeller effluent splitter distribution w/ marker

New well not installed at this time

Setbacks from storm drain maintained

Permit can be suspended or revoked if any false information is supplied toward securing the permit/any unauthorized changes are made to the site/any unauthorized changes are made in the installation of the system. Improvement Permit with plat valid without expiration. Improvement Permit with site plan valid for sixty months. Authorization to Construct is valid for a period equal to that of Improvement Permit – not to exceed sixty months.

Signed: Susan Dewey date 8-25-05 Installed by: A-1 Backhoe

Improvement Permit by: Judy Melville date 8-25-05 Operation Permit by: Judy Melville date 2-17-06

Authorization to Construct by: Judy Melville date 8-25-05 Existing System Inspection by: ______ date ______

HEALTH DEPT. COPY: WHITE OWNER COPY (FINAL): YELLOW OWNER COPY (INITIAL): PINK