IREDELL COUNTY HEALTH DEPARTMENT

300

STATESVILLE 704-878-5305 MOORESVILLE 704-664-5281

IMPROVEMENT PERMIT / AUTHORIZATION TO CONSTRUCT / OPERATION PERMIT / EXISTING SYSTEM INSPECTION

PERMIT# Repair PIN# 4637342168 DATE 2/24/06

OWNER OR APPLICANT Ryan Hoce PHONE: Business Home

ADDRESS 2207 Heritage ct Kannapolis NC 28083

LOCATION 150 W, TL Doolie, TR Whippoorwill, TL Little Acorn, at End #124

SUBDIVISION CL+T BLOCK / SECTION 10 LOT 29 LOT AREA SITE CLASS. P3 DESIGN FLOW 360 L.T.A.R. —

Septic Tank: 1000 Gallons; STB 794 Date 1/16/06
Pump Tank: Gallons; PT Date
Pump Make: Model Serial No.
Nitrification Field: No Fields Square Feet — Linear Feet —
No Lines — Trench Width — Max Trench Bottom Depth — Gravel Depth —

☐ New System ☒ Repair ☐ Expansion System Type: I (II) III IV V VI
System Description: Existing System
Repair System Description:
Maintenance Agreement Required: ☒ Yes ☐ No

☒ House/Mod. Home ☐ Mobile Home ☐ Business ☐ Other
No. Bedrooms 3 No. Persons No. Employees


Water Supply: ☒ Individual ☐ Public ☐ Community

☐ Gravity ☒ Pressure ☐ Slab ☒ Crawl Space ☐ Basement w/plumbing ☐ Basement wo/plumbing

Comments:/Conditions: Replace ST + D-Box


Not to Scale

INITIAL SITE SKETCH

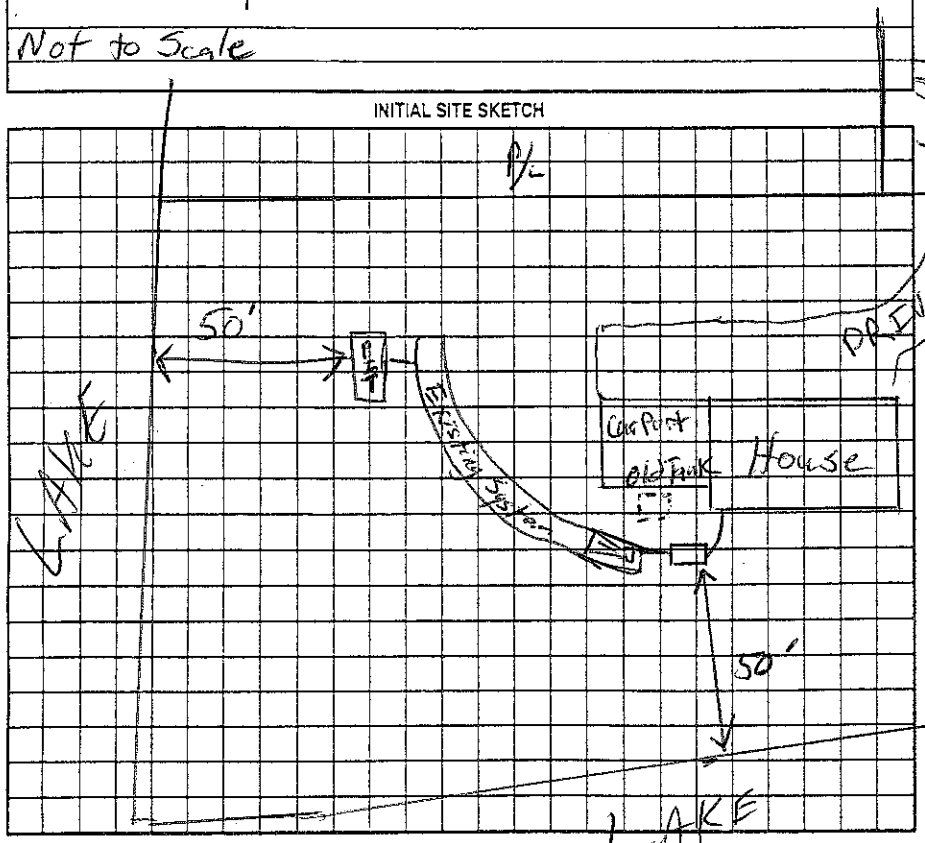

Comments:/Conditions: Exist Permit - Fred Griffth - 1977 Copy Attached

AS BUILT SKETCH

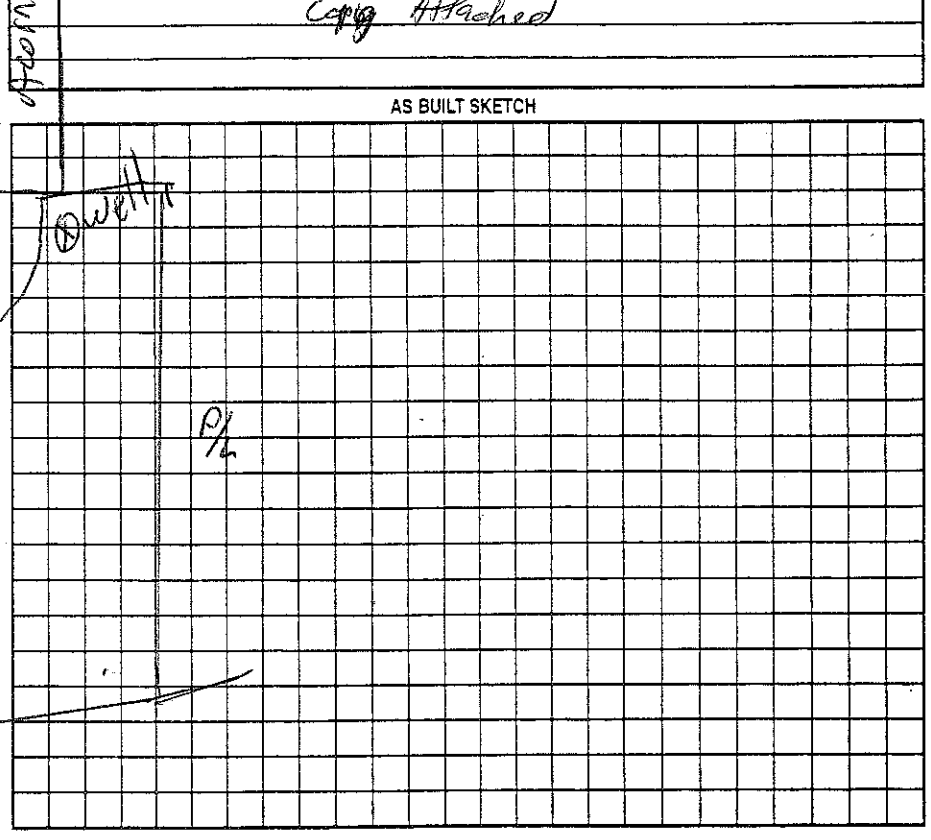

Permit can be suspended or revoked if any false information is supplied toward securing the permit/any unauthorized changes are made to the site/any unauthorized changes are made in the installation of the system. Improvement Permit with plat valid without expiration ☐ Improvement Permit with site plan valid for sixty months ☐ Authorization to Construct is valid for a period equal to that of Improvement Permit – not to exceed sixty months.

Signed: Ryan A Hoce date

Improvement Permit by: RS date 2/24/06

Authorization to Construct by: RS date 2/24/06

Installed by: Specialty Septic

Operation Permit by: RS date 3/7/06

Existing System Inspection by: date

HEALTH DEPT. COPY: WHITE OWNER COPY (FINAL): YELLOW OWNER COPY (INITIAL): PINK

IREDELL COUNTY HEALTH DEPARTMENT

STATESVILLE 704-878-5305 MOORESVILLE 704-664-5281

IMPROVEMENT PERMIT / CERTIFICATE OF COMPLETION / OPERATION PERMIT / EXISTING SYSTEM INSPECTION

PROPERTY DESCRIPTION NO. Repair DATE 3/30/95 TAX MAP NO. Repair Watershed: ☑ Yes ☐ No

OWNER OR CONTRACTOR Fred Griffith PHONE: Business Home 664-3803

ADDRESS 124 Little Arrow Ln. Mooresville, NC. 28115

LOCATION 150 W. To on Doolie Rd. TR on Whippoorwill To on Little Arrow to end

SUBDIVISION CL+T BLOCK / SECTION 10 LOT 29 LOT AREA Empty SITE CLASS. — DESIGN FLOW 480 L.T.A.R. — P/REPAIR

Septic Tank: 1000 Gallons; STB Date

Pump Tank: Gallons; PT Date

Pump Make: Model Serial No.

Nitrification Field: No Fields 1 Square Feet 400 Linear Feet 100

No Lines 2 Trench Width 8' Max Trench Bottom Depth 36-40" Gravel Depth 12-14"

☐ New System ☑ Repair System Type: I, II, III, IV, V, VI

System Description: CONV - BED

Repair System Description:

Maintenance Agreement Required: ☐ Yes ☑ No

☑ House/Mod. Home No. Bedrooms 3

☐ Mobile Home No. Bathrooms 2

☐ Business No. Employees

☐ Other


☐ Slab ☑ Crawl Space ☐ Basement w/plumbing ☐ Basement wo/plumbing

Water Supply: ☑ Individual ☐ Community ☐ Public

Comments:

Comments:

INITIAL SITE SKETCH

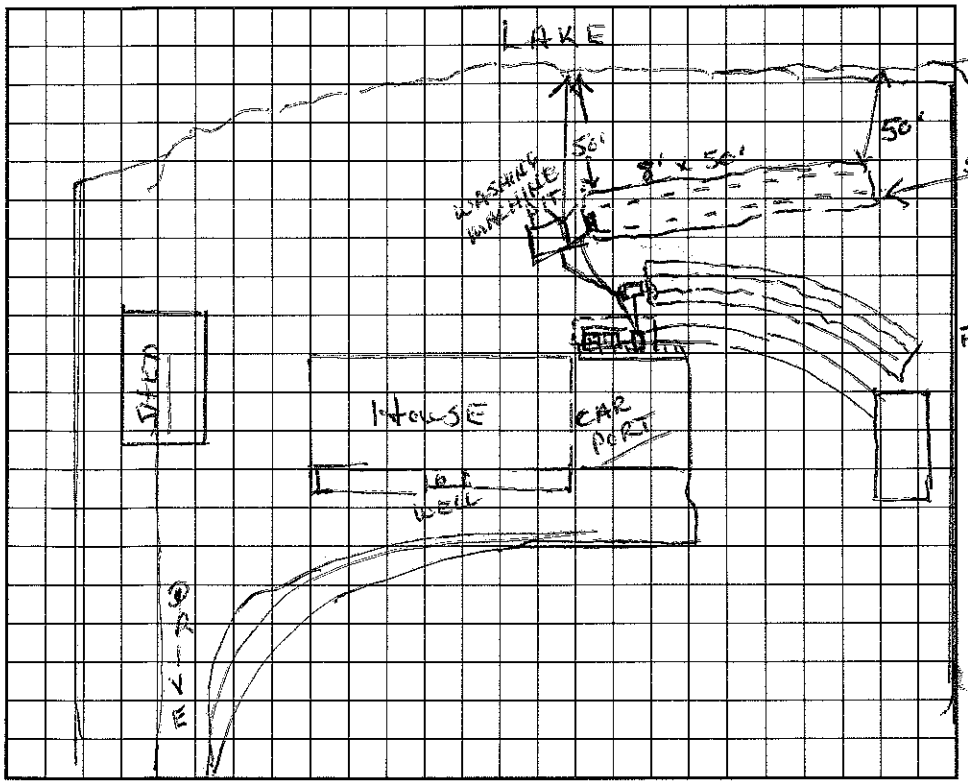

AS BUILT SKETCH

I understand that this permit can be suspended or revoked if any false information is supplied toward securing the permit/any unauthorized changes are made to the site/any unauthorized changes are made in the installation of the system. Improvement Permit is valid for 60 months from date of issuance.

Signed:

Improvement Permit by: Wesley Sparks R.S. date 3/30/95

Existing System Inspection by: date

Installed by: Myers Septic Tank

Certificate of Completion by: Wesley Sparks R.S. date 5/3/95

Operation Permit by: date

HEALTH DEPT. COPY: WHITE INSPECTION COPY (FINAL): GREEN OWNER COPY (FINAL): YELLOW INSPECTION COPY (INITIAL): PINK OWNER COPY (INITIAL): GOLD