IREDELL COUNTY HEALTH DEPARTMENT

Statesville Office (704) 878-5305 Mooresville Office (704) 660-3625 PERMIT # 209328

IMPROVEMENT PERMIT / AUTHORIZATION TO CONSTRUCT / OPERATION PERMIT / EXISTING SYSTEM

PIN # 4637-34-2322.000

APPLICANT: Samuel G. Scott APPLICANT ADDRESS: 2278 Chipley Ford Rd. Statesville NC

SITE ADDRESS: 118 Little Acorn Ln. Mooresville NC PHONE: 704-902-3280 ALT. PHONE:

SITE DIRECTIONS: 150 W, TL Dooley Rd., TR Whippoorwill TL Little Acorn Ln, 3RD LOT ON R

SUBDIVISION: CL & T SECTION: 10 LOT # 30 LOT AREA: DESIGN FLOW: 360 GPD. L.T.A.R.: EXISTING

Septic Tank 1000 (gal)	STB	Date	☐ New System ☐ Repair ☐ Expansion System Type: I ☒ II III IV V VI	☒ Residence	No. Bedrooms 3	Water Supply
Pump Tank (gal)	PT	Date	System Description: EXISTING CONVENTIONAL - GRAVITY	☐ Business	No. Persons 6	☒ Private
Pump Make Model	Serial #		Repair System Description: LP PPBPS (EXEMPT) (1976)	☐ Other	No. Employees	☐ Public
# Nitrification Fields 1	# Lines EXISTING 3	Linear Ft: EXISTING	Maintenance Agreement Required: ☐ YES ☒ NO	☐ Slab	☒ Crawl Space	☐ Community
Trench Width EXISTING	Max. Trench Bottom Depth EXISTING	Gravel Depth EXISTING	☒ GRAVITY ☐ PRESSURE	☐ Basement w/plumbing	☐ Basement w/o plumbing	

Comments / Conditions: MAINTAIN 5' SEPERATION FROM PROPOSED NEW HOME WITH NEW SEPTIC TANK AND ANY EXISTING SEPTIC LINES. CONNECT NEW TANK TO EXISTING SEPTIC LINES.

REPAIR DRAINS IN PREVIOUSLY APPROVED AREA. LOT IS REPAIR EXEMPT. MAINTAIN AT LEAST 50' FROM WELL IF REPAIR IS EVER UTILIZED. EXISTING SYSTEM APPEARED TO BE FUNCTIONING AT TIME OF INSPECTION.


INITIAL SITE SKETCH

CRUSH AND FILL OLD TANK.

1" = 40'

LITTLE ACORN LN

AS BUILT SKETCH

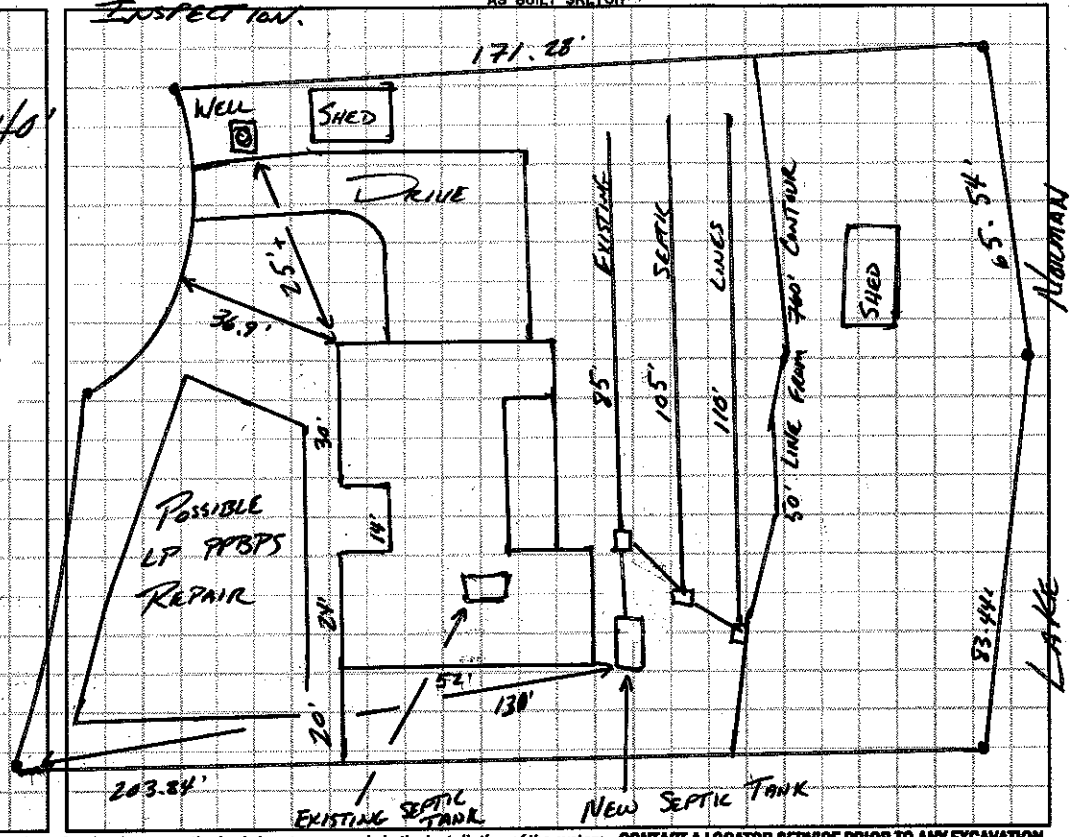

Permit can be suspended or revoked if any false information is supplied toward securing the permit / any unauthorized changes are made to the site / any unauthorized changes are made in the installation of the system. **CONTACT A LOCATOR SERVICE PRIOR TO ANY EXCAVATION**

☐ **IMPROVEMENT PERMIT** *with plat valid without expiration* ☒ **IMPROVEMENT PERMIT** *with site plan valid for 60 mos.* ☒ **AUTHORIZATION TO CONSTRUCT** *valid for period equal to IMPROVEMENT PERMIT--not to exceed 60 mo.*

Owner / Applicant Signature: Samuel G Scott Date: 5-14-15 Installed by: YOUNTZ

IMPROVEMENT PERMIT by: APPROVED MAY 13 2015 Date:

AUTHORIZATION TO CONSTRUCT by: APPROVED MAY 13 2015 Date:

OPERATION PERMIT by: Date: 3-24-16

Existing System Inspected by: Date:

Health Dept. Copy - WHITE Applicant (Final Approval) - YELLOW Applicant (Conditional Approval) - PINK