IREDELL COUNTY HEALTH DEPARTMENT

Statesville Phone TR 3-7271 Mooresville Phone NO 3-1271

PERMIT TO INSTALL SEPTIC TANK

Permit No. 44 Permit Date MAY 19 1971

Owner ALLEN T. BILLA Address 1015 Graceland Dr. GREENSBORO, N.C.

Installed By Adams Address TAYLORSVILLE, NC


Location of Property W. Highway #150. Turn LEFT on Road #1160 - (Holly Hill). SECTION 10 - LOT 34

Tank		Capacity		Length of Lines		Fixtures	
Block	( )	1000	(✓)	225'	(✓)	No. of Baths	(1)
Precast	(✓)	1250	( )	250'	( )	Dishwasher	( )
		1500	( )	Other		Garbage Grdr.	( )
		Other				Other	

NOTIFY HEALTH DEPARTMENT AT LEAST EIGHT HOURS BEFORE TANK IS TO BE INSPECTED.

Final Inspection MAY 19 1971 Approved ( ) Disapproved ( )

Remarks

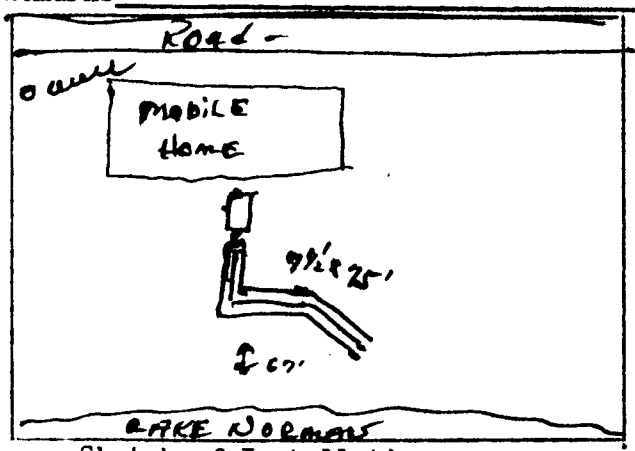

Sketch of Installation

MAYBE TREES too CLOSE TO FIELD - OWNERS RESPONSIBILITY.

Sanitarian