IREDELL COUNTY HEALTH DEPARTMENT

STATESVILLE 704-878-5305 MOORESVILLE 704-664-5281

IMPROVEMENT PERMIT / CERTIFICATE OF COMPLETION / OPERATION PERMIT / EXISTING SYSTEM INSPECTION

PROPERTY DESCRIPTION NO. 17992 DATE Feb 15, 95 TAX MAP NO. 2P14A 41 4637 34 7879 Watershed: ☑ Yes ☐ No

OWNER OR CONTRACTOR Jon Grigorian / Genesis Dev Ltd. PHONE: Business _____ Home _____ WSIV

ADDRESS PO Box 144, Statesville Ford, NC

LOCATION 150 W TR Doolie, TR Whippoorwill ~ 1 mile on Right

SUBDIVISION Whippoorwill Woods BLOCK / SECTION 1 LOT 41 LOT AREA _____ SITE CLASS. PS DESIGN FLOW 360 gpd L.T.A.R. ~.35

Septic Tank: 1000 Gallons; STB 794 Date 4/23/97

Pump Tank: 1000 Gallons; PT _____ Date _____

Pump Make: _____ Model _____ Serial No. _____

Nitrification Field: No Fields 1 Square Feet 1050 Linear Feet 350

No Lines 5 Trench Width 36" Max Trench Bottom Depth 30" Gravel Depth 12"

☐ New System ☐ Repair System Type: I, II, ☑ III, IV, V, VI

System Description: pumped conventional

Repair System Description: same or LPP BPS

Maintenance Agreement Required: ☐ Yes ☐ No

☑ House/Mod. Home No. Bedrooms 3

☐ Mobile Home No. Bathrooms _____

☐ Business No. Employees _____

☐ Other _____


☐ Slab ☐ Crawl Space ☑ Basement w/plumbing ☐ Basement wo/plumbing

Water Supply:
☑ Individual
☐ Community
☐ Public


Comments: Pressure manifold of 4" sch 80 pipe - ½" taps 6" o.c. laterals to 0 foot contour and kept shallow.

Comments:

INITIAL SITE SKETCH

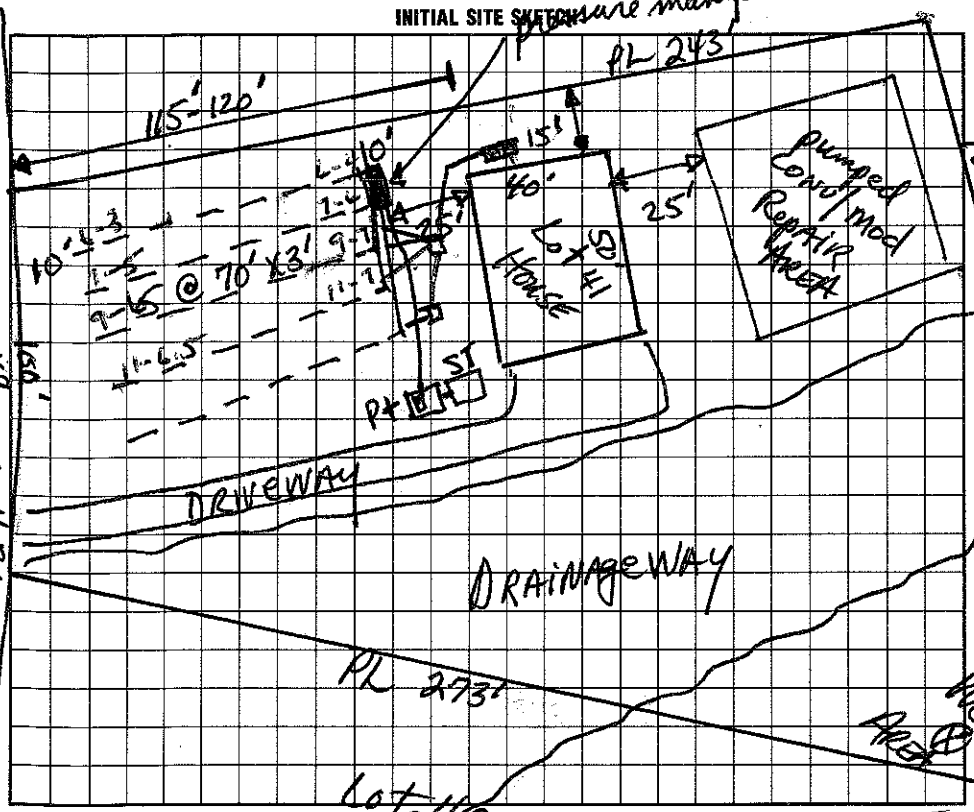

AS BUILT SKETCH

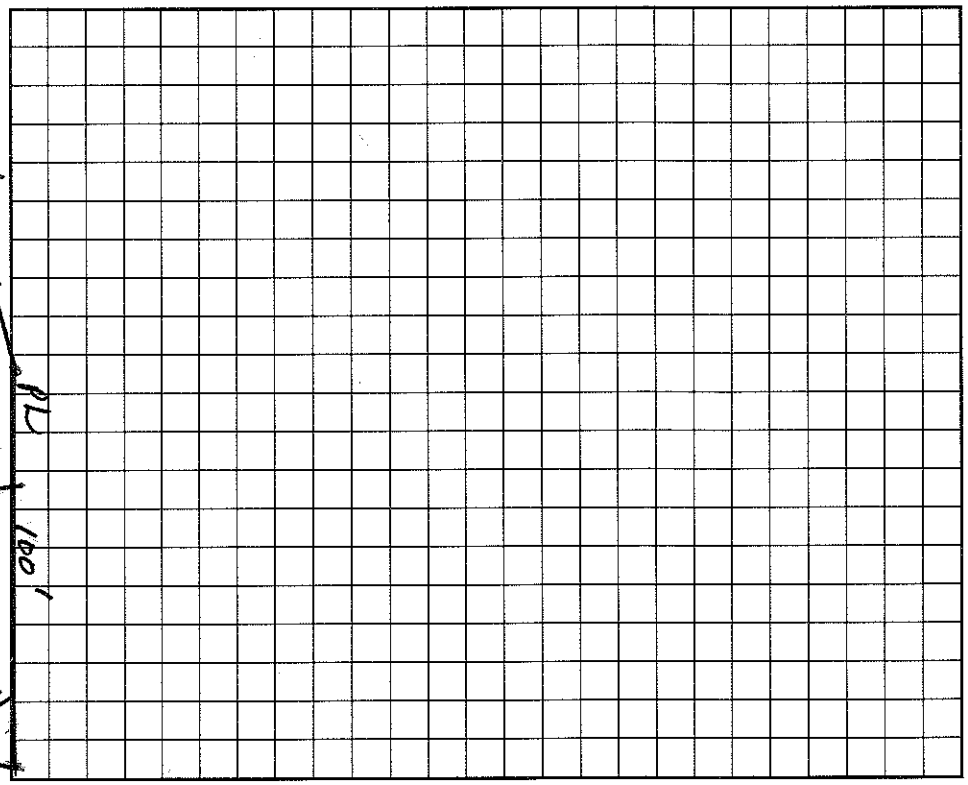

I understand that this permit can be suspended or revoked if any false information is supplied toward securing the permit/any unauthorized changes are made to the site/any unauthorized changes are made in the installation of the system. Improvement Permit is valid for 60 months from date of issuance.

Signed: _____ Agent

Improvement Permit by: _____ date 2/15/95

Existing System Inspection by: _____ date _____

Installed by: Dave Clark

Certificate of Completion by: Wesley Sparks R.S. date 7/17/97

Operation Permit by: Wesley Sparks R.S. date 7/17/97

HEALTH DEPT. COPY: WHITE INSPECTION COPY (FINAL): GREEN OWNER COPY (FINAL): YELLOW INSPECTION COPY (INITIAL): PINK OWNER COPY (INITIAL): GOLD