4037348330

IREDELL COUNTY HEALTH DEPARTMENT

STATESVILLE 704-878-5305 MOORESVILLE 704-664-5281

IMPROVEMENT PERMIT / CERTIFICATE OF COMPLETION / OPERATION PERMIT / EXISTING SYSTEM INSPECTION

PROPERTY DESCRIPTION NO. 16510 DATE June 15, '93 TAX MAP NO. 2P-3-A-23

OWNER OR CONTRACTOR L.A. Overcash SR. PHONE: Business Home

ADDRESS 1005 Orangewood St. Kannapolis

LOCATION 150 W. TL Dootle Rd. TR Whippoorwill 1/4-1/2 mile on left

SUBDIVISION Crescent Lake Norman BLOCK / SECTION 10 LOT 23 LOT AREA Existing SITE CLASS. L.T.A.R.

Water Supply: ☑ Individual ☐ Community ☐ Public

Septic Tank: Existing Gallons; STB Date

Pump Tank: Gallons; PT Date

Nitrification Field: No Fields Existing Square Feet Linear Feet

No Lines Trench Width Trench Depth Gravel Depth

☐ New System ☐ Repair System Type: I, II, II, IV, V, VI

System Description: Existing

Repair System Description:

Maintenance Agreement Required: ☐ Yes ☑ No

☐ House/Mod. Home ☑ Mobile Home ☐ Business ☐ Other

No. Bedrooms 2 No. Bathrooms 1-2 No. Employees

☐ Slab ☑ Crawl Space ☐ Basement w/plumbing ☐ Basement wo/plumbing

Garbage Disposal: ☐ Yes ☑ No

Auto. Dishwasher: ☑ Yes ☐ No


Auto. Washing Machine: ☑ Yes ☐ No

Other

Comments Existing system showing no sign of malfunction at time of inspection of Replacing 2 bedroom SW Mobile Home with another 2 bedroom SW Mobile Home.

INITIAL SITE SKETCH

AS BUILT SKETCH

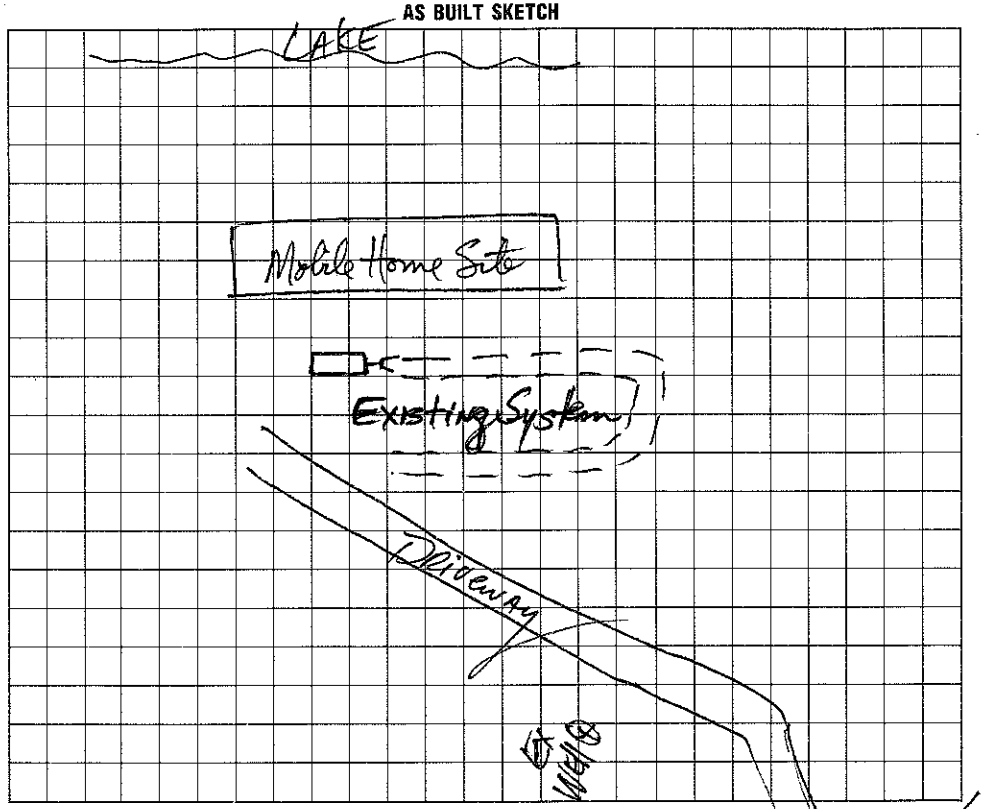

I understand that this permit can be suspended or revoked if any false information is supplied toward securing the permit/any unauthorized changes are made to the site/any unauthorized changes are made in the installation of the system. Improvement Permit is valid for 60 months from date of issuance.

Signed:

Improvement Permit by: date

Existing System Inspection by: David R. Hinson RS date 6/15/93

Installed by:

Certificate of Completion by: date

Operation Permit by: date

HEALTH DEPT. COPY: WHITE INSPECTION COPY (FINAL): GREEN OWNER COPY (FINAL): YELLOW INSPECTION COPY (INITIAL): PINK OWNER COPY (INITIAL): GOLD