IREDELL COUNTY HEALTH DEPARTMENT

STATESVILLE 704-878-5305 MOORESVILLE 704-664-5281

IMPROVEMENT PERMIT / CERTIFICATE OF COMPLETION / OPERATION PERMIT / EXISTING SYSTEM INSPECTION

PROPERTY DESCRIPTION NO 17994 DATE Feb 16, '95 TAX MAP NO. 2P14A 40 4637349827 Watershed: ☑ Yes ☐ No WS IV

OWNER OR CONTRACTOR Jon Hisorian PHONE: Business _____ Home _____

ADDRESS PO Box 44 Sherrills Ford, NC

LOCATION 150 W Fr Dobie Rd TR Whippoorwill Rd ~1/mile on right

SUBDIVISION Whippoorwill Woods BLOCK / SECTION 1 LOT 140 LOT AREA ~1 Ac SITE CLASS PS DESIGN FLOW 360 gpd L.T.A.R. .3

Septic Tank: 1000 Gallons; STB 794 Date 4/28/97

Pump Tank: _____ Gallons; PT _____ Date _____

Pump Make: _____ Model _____ Serial No. _____

Nitrification Field: No Fields 1 Square Feet 1200 Linear Feet 400

No Lines 3 Trench Width 36" Max Trench Bottom Depth 30" Gravel Depth 12"

☑ New System ☐ Repair System Type: I, II, III, IV, V, VI

System Description: gravity conventional

Repair System Description: pumped conv/mod.

Maintenance Agreement Required: ☐ Yes ☐ No

☑ House/Mod. Home No. Bedrooms 3

☐ Mobile Home No. Bathrooms 2

☐ Business No. Employees _____

☐ Other _____


☐ Slab ☑ Crawl Space ☐ Basement w/plumbing ☐ Basement wo/plumbing

Water Supply: ☑ Individual ☐ Community ☐ Public

Comments: Modify drainageway by defining a surface drainage ditch to culvert pipe & Exit plumbing at existing grade at right rear house corner, Follow contour w/ laterals

Comments:

INITIAL SITE SKETCH

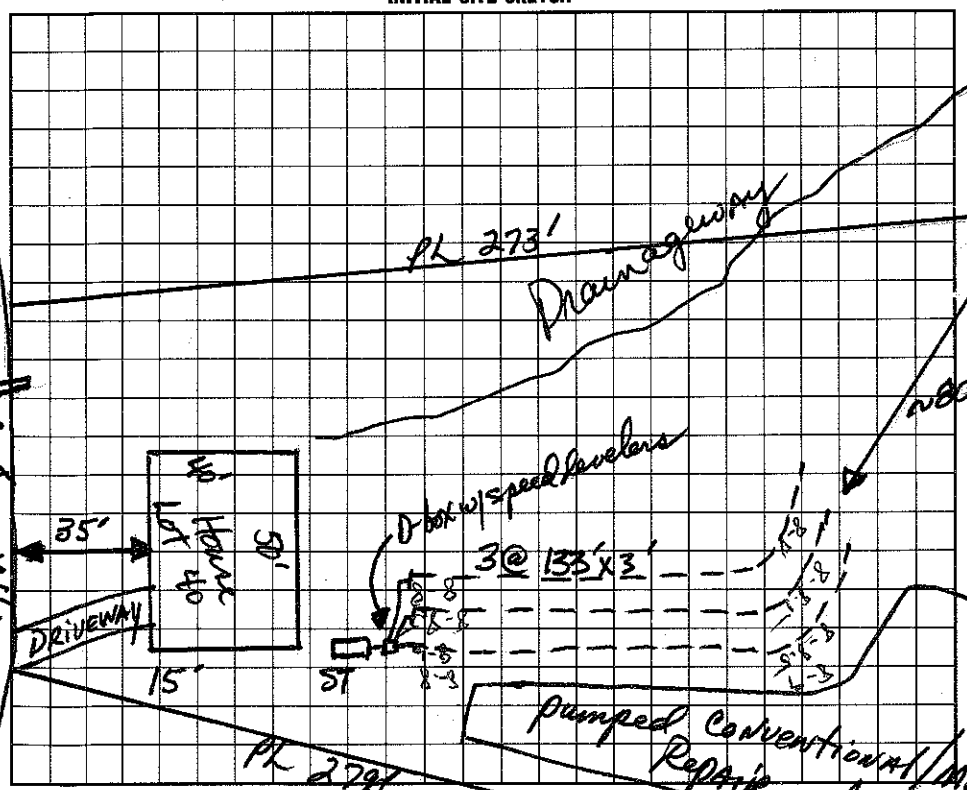

AS BUILT SKETCH

I understand that this permit can be suspended or revoked if any false information is supplied toward securing the permit/any unauthorized changes are made to the site/any unauthorized changes are made in the installation of the system. Improvement Permit is valid for 60 months from date of issuance.

Signed: _____ Agent

Improvement Permit by: _____ date 2-16-95

Existing System Inspection by: _____ date _____

Installed by: Dave Clark

Certificate of Completion by: Wesley Sparks RS. date 7/16/97

Operation Permit by: Wesley Sparks RS. date 7/16/97

HEALTH DEPT. COPY: WHITE INSPECTION COPY (FINAL): GREEN OWNER COPY (FINAL): YELLOW INSPECTION COPY (INITIAL): PINK OWNER COPY (INITIAL): GOLD