IREDELL COUNTY HEALTH DEPARTMENT

Statesville Phone TR 3-7271 Mooresville Phone No. 664-5281

PERMIT TO INSTALL SEPTIC TANK

Permit No. 48 Permit Date 4-10- 1973

Owner Mack Mills Address Mooresville

Installed By F.T. Ervin Address Mooresville


Location of Property 150 W TW on 1180 Then TR on 1221 1mi on left

Tank		Capacity		Length of Lines		Fixtures	
Block	( )	1000	(✓)	225'	(✓)	No. of Baths	(2)
Precast	(✓)	1250	( )	250'	( )	Dishwasher	( )
		1500	( )	Other		Garbage Grdr.	( )
		Other				Other Washing Machine	

NOTIFY HEALTH DEPARTMENT AT LEAST EIGHT HOURS BEFORE TANK IS TO BE INSPECTED.

Final Inspection 4-10- 1973 Approved (✓) Disapprcved ( )

Remarks well should be located 100' from septic tank system

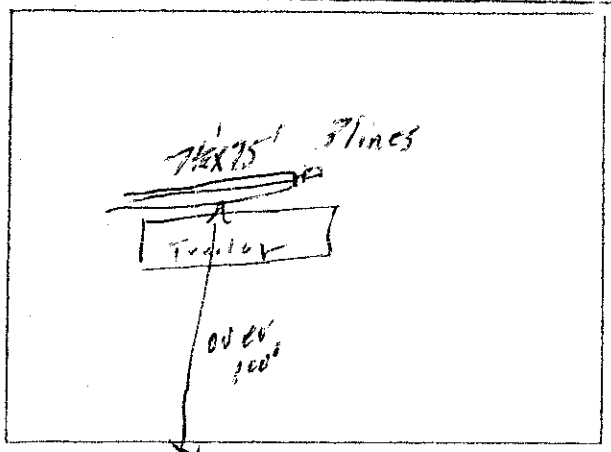

Sketch of Installation

F. T. Ervin
Sanitarian